

GLADWIN COUNTY REMONUMENTATION

LAND CORNER RECORDATION CERTIFICATE
Filing Requirement of Act 74, Mich. P.A. 1970

LIBER 001 PAGE 184

For corners in

GLADWIN

(County)

Located in:

Corner Code #

- | | | | | | |
|------------------------------------|---|-----|---|----|------|
| 1. Public Land Survey | T | 19N | R | 1W | B-13 |
| | T | | R | | |
| | T | | R | | |
| | T | | R | | |
| 2. Property Controlling in Section | S | | T | R | |
| | S | | T | R | |
| 3. Miscellaneous Property in Sec. | S | | T | R | |
| | S | | T | R | |
4. Lot No. _____, Recorded Plat _____
5. Private Claims _____

STATE OF MICHIGAN
GLADWIN COUNTY
FILED - Remonumentation

17 OCT 97 1:21 P.M.

RONNIE K. HOUSE
REGISTER OF DEEDS

Register of Deeds Stamp & File Number

I, MARK R. ROBISON, in a field survey on May 6, 1997 do hereby state that under requirements of P.A. 74, Michigan P.A. of 1970, the corner points mentioned in lines 1 and 2 above were in conformance with regulations and rules therefore as required in the current manual of survey instructions of the United States Department of the Interior, Bureau of Land Management or by a decree of a Court of Law and/or that the corner points mentioned in lines 3, 4 and 5 above were in conformance with the rules of the Michigan Board of Land Surveyors or by a Decree of a Court of Law, established, re-established, monumented, recovered, found as expressed below:

NOTE: Not more than 2 corners, all in the same town and range, may be recorded on this certificate.

A	B	C	D	E	F	G	H	I	J	K	L	M
1												
2	6		5		4		3		2		1	
3												
4	7		8		9		10		11		12	
5												
6	18		17		16		15		14		13	
7												
8	19		20		21		22		23		24	
9												
10	30		29		28		27		26		25	
11												
12	31		32		33		34		35		36	
13												

- A. Description of original monument and accessories and/or subsequent restoration:
- 1877 T. Gale Merrill Set Post
Wit.-(1)N24E 21 links 18" Cedar
(2)N18W 28 links 12" Pine
 - 1974 Lapham survey Set capped iron
Wit.-(3)N45E 25.6' city limits sign
(4)S45W 29.0' center Hyd.
(5)S45E 113.1' tag in pole
 - 1976 Lapham survey Found capped iron
Wit.-same as (3),(4)&(5)
 - 1980 Lapham L.C.R.C.#235 Found capped iron
Wit.-(6)N30W Cor Post 34.70'
(7)N20E Power Pole 48.17'
(8)South, conc. mon, 33.80'

1980 Owen Ayres survey

1987 Lapham survey Found 1/2" iron
Wit.-same as (3),(4)&(5)

1991 Lapham survey Wit.-same as (6),(7)&(8)

1992 Lapham survey Wit.-same as (3),(4)&(5)

B. Description of corner evidence found and/or method applied in restoring or reestablishing corner:

Found R.R. spike in centerline bituminous county road opposite chain link fence to South and centerline lane to North. Found (4); measured 29.05', recorded 29.00'. Found (8); measured 33.75', recorded 33.80'. Found (7); measured 48.23', recorded 48.17'. Set Gladwin County Re-mon in place of found R.R. spike.

See dossier for detailed report.

APPROVED LAND CORNER
P.A. 345 of 1990
Gladwin County

Co. Rep. John Meyer
Date 5/18/97

C. Description of monument for corner and accessories established to perpetuate locating the position of the corner:

B-13: Corner common to Section 6, T18N, R1W, and Section 31, T19N, R1W. Set 5/8" x 36" rerod with Gladwin County Re-mon Cap marked P.S.#27458.


SURVEY &
REMONUMENTATION

JAN 08 1998

SECTION

- Witnesses:
- South, Concrete Monument, 33.75'
 - N10E Power Pole, nail & tag, 48.23'
 - S10E Power Pole, nail & tag, 64.50'
 - N45W 8" Basswood, nail & tag, 42.85'
 - S45W, center top Hydrant, 29.05'

Signed by Mark R. Robison
Surveyor's Michigan License No. 27458

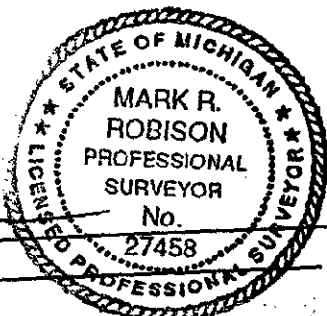

Date 10-7-97