

DEC 1 6 1996

**GLADWIN COUNTY REMONUMENTATION**

**COMMISSION**

**LAND CORNER RECORDATION CERTIFICATE**  
Filing Requirement of Act 74, Mich. P.A. 1970

LIBER **001** PAGE **109**

For corners in

<u>GLADWIN</u> (County)	Located In:	Corner Code #
1. Public Land Survey	T <u>19N</u> R <u>1W</u>	<u>C - 11</u>
	T <u>    </u> R <u>    </u>	<u>    </u>
	T <u>    </u> R <u>    </u>	<u>    </u>
	T <u>    </u> R <u>    </u>	<u>    </u>
2. Property Controlling in Section	S <u>    </u> T <u>    </u> R <u>    </u>	<u>    </u>
	S <u>    </u> T <u>    </u> R <u>    </u>	<u>    </u>
3. Miscellaneous Property in Sec.	S <u>    </u> T <u>    </u> R <u>    </u>	<u>    </u>
	S <u>    </u> T <u>    </u> R <u>    </u>	<u>    </u>

STATE OF MICHIGAN  
GLADWIN COUNTY  
FILED-REMONUMENTATION

2 DEC 96 3:25 P.M.

BONNIE K. HOUSE  
REGISTER OF DEEDS

Register of Deeds Stamp & File Number

4. Lot No. \_\_\_\_\_, Recorded Plat \_\_\_\_\_  
5. Private Claims \_\_\_\_\_

I, MARK ROBISON, in a field survey on November, 19 96, do hereby state that under requirements of P.A. 74, Michigan P.A. of 1970, the corner points mentioned in lines 1 and 2 above were in conformance with regulations and rules therefore as required in the current manual of survey instructions of the United States Department of the Interior, Bureau of Land Management or by a decree of a Court of Law and/or that the corner points mentioned in lines 3, 4 and 5 above were in conformance with the rules of the Michigan Board of Land Surveyors or by a Decree of a Court of Law; established, re-established, monumented, recovered, found as expressed below:

NOTE: Not more than 2 corners, all in the same town and range, may be recorded on this certificate.

	A	B	C	D	E	F	G	H	I	J	K	L	M
1													
2	6		5		4		3		2		1		
3													
4	7		8		9		10		11		12		
5													
6	18		17		16		15		14		13		
7													
8	19		20		21		22		23		24		
9													
10	30		29		28		27		26		25		
11													
12	31		32		33		34		35		36		
13													

A. Description of original monument and accessories and/or subsequent restoration:

- |  |  |
|--|--|
| 1877 T. GALE MERRILL SET POST<br>WIT.-(1)CEDAR 8 S15W 66<br>(2)DO 17 N8E 08<br>1900 DUANE SURVEY<br>PLANTED CEDAR STAKE & 3/8" GAS PIPE<br>WIT.-(3)PINE STUMP 18 N37 1/2W 24LKS<br>(4)DO 18 N49 1/2E 34LKS<br>1950+/- EDMANDS ENG.-WORKING FILE<br>WIT.-NONE<br>1973 PAUL LAPHAM L.C.R.C.#70<br>FOUND 1/2" REROD IN CEDAR POST | WIT.-(5)N45E 36.85 COR. FE. POST<br>(6)SOUTH 30.45 COR. FE. POST<br>(7)N30W 76.25 P.P.<br>1973 PAUL LAPHAM SURVEY<br>WIT.-SAME AS (5),(6)&(7)<br>1991 PAUL LAPHAM-UNRECORDED L.C.R.C.<br>FOR CO. ROAD CONSTRUCTION<br>FOUND 1/2" REBAR<br>WIT.-(8)N45W P.P. 81.72<br>(9)N30E P.P. 72.40<br>(10)SOUTH COR. POST 27.55 |
|--|--|

(11)S45E 6" CENTER RED PINE 42.65  
1984 PAUL LAPHAM-WORKING DRAWING  
1984 PAUL LAPHAM SURVEY  
WIT.-SAME AS (5),(6)&(7)

B. Description of corner evidence found and/or method applied in restoring or reestablishing corner:

FOUND 1/2" REROD OVER 2-1" GAS PIPES IN C/L E-W ROAD, T-ROAD NORTH. FOUND (8); REC. 81.72, M 81.76. FOUND (9); REC. 72.40, MEAS. 72.50. SET GLADWIN RE-MON BETWEEN FOUND GAS PIPES.


APPROVED LAND CORNER  
P.A. 3/5 of 1990  
Gladwin County

Co. Rep. Mark Robison  
Date 11/6/96

SEE DOSSIER FOR DETAILED REPORT.

C. Description of monument for corner and accessories established to perpetuate locating the position of the corner:

- C-11: CORNER COMMON TO SECTIONS 29, 30, 31, 32  
SET 5/8" X 3/8" REROD WITH GLADWIN RE-MON CAP MARKED P.S.#27458
- WITNESSES:  
N45W POWER POLE, SPIKE AND CAP, 81.67'  
N30E POWER POLE, N&T, 72.50'  
SOUTH COR. POST, N&T, 27.55'  
S45E 6" RED PINE, SPIKE, 42.65'

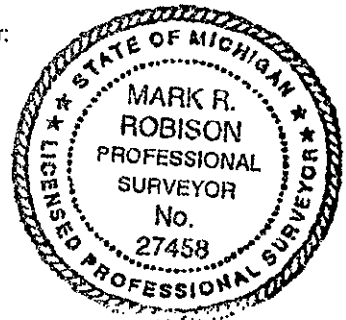

Signed by Mark R. Robison  
Surveyor's Michigan License No. 27458

Date 11-29-96