

GLADWIN COUNTY REMONUMENTATION

LIBER 001 PAGE 185

LAND CORNER RECORDATION CERTIFICATE  
Filing Requirement of Act 74, Mich. P.A. 1970

For corners in

GLADWIN

(County)

Located In:

Corner Code #

1. Public Land Survey

T 19N R 1W

C-13

T R

T R

T R

2. Property Controlling in Section

S T R

S T R

3. Miscellaneous Property in Sec.

S T R

S T R

STATE OF MICHIGAN  
GLADWIN COUNTY

FILED - Remonumentation

17 OCT 97 1:21 P.M.

BONNIE K. HOUSE  
REGISTER OF DEEDS

Register of Deeds Stamp & File Number

4. Lot No. \_\_\_\_\_, Recorded Plat \_\_\_\_\_  
5. Private Claims \_\_\_\_\_

I, MARK R. ROBISON, in a field survey on May 23, 19 97 do hereby state that under requirements of P.A. 74, Michigan P.A. of 1970, the corner points mentioned in lines 1 and 2 above were in conformance with regulations and rules therefore as required in the current manual of survey instructions of the United States Department of the Interior, Bureau of Land Management or by a decree of a Court of Law and /or that the corner points mentioned in lines 3, 4 and 5 above were in conformance with the rules of the Michigan Board of Land Surveyors or by a Decree of a Court of Law; established, re-established, monumented, recovered, found as expressed below:

NOTE: Not more than 2 corners, all in the same town and range, may be recorded on this certificate.

1	A	B	C	D	E	F	G	H	I	J	K	L	M
2		6		5		4		3		2		1	
3													
4		7		8		9		10		11		12	
5													
6		18		17		16		15		14		13	
7													
8		19		20		21		22		23		24	
9													
10		30		29		28		27		26		25	
11													
12		31		32		33		34		35		36	
13													

A. Description of original monument and accessories and/or subsequent restoration:  
 1877 T. Gale Merrill Set Post  
 1980 Lapham L.C.R.C.#235 Wit.-same as (3),(4)&(5)  
 1994 Lapham working dwg.  
 1979 Lapham survey Found 3/8" iron  
 Wit.-(3)N35E Apple 88.45'  
 (4)N45E 10" Willow 56.88'  
 (5)N45W Pow Pole 127.30'

APPROVED LAND CORNER  
P.A. 345 of 1990  
Gladwin County  
Co. Rep. [Signature]  
Date 9/18/97


B. Description of corner evidence found and/or method applied in restoring or reestablishing corner:  
 Found cabin spike (3/8" head) in centerline of road, 1' below surface. Found (5); recorded & measured, Nail & tag, 127.30'. Found (3); no tag, measured 88.22' to center of tree, recorded 88.45'. Set Gladwin County Re-mon in place of found cabin spike.  
 GLO recorded 99.0, measured 99.05.  
 See dossier for detailed report.

C. Description of monument for corner and accessories established to perpetuate locating the position of the corner:  
 C-13: Corner on township line, common to Sections 31 & 32.  
 Set 5/8" x 3/8" rod with Gladwin County Re-mon Cap marked P.S.#27458.

Witnesses:  
 N68W Power Pole, nail & tag, 127.30'  
 N35E 12" Apple, nail & tag, 88.22'  
 S50E 6" Scotch Pine, nail & tag, 51.07'  
 N45E SW Corner House (Block) 121.72'  
 East, NE Corner, Section 6, T18N, R1W, 99.05'

SURVEY & REMONUMENTATION  
 JAN 08 1998  
 SECTION

Signed by [Signature]  
 Surveyor's Michigan License No. 27458

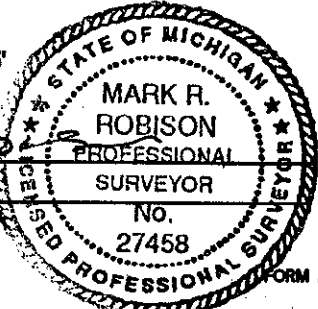

Date 10-7-97