

GLADWIN COUNTY REMONUMENTATION

LIBER 001 PAGE 186

LAND CORNER RECORDATION CERTIFICATE  
Filing Requirement of Act 74, Mich. P.A. 1970

For corners in

GLADWIN

(County)

Located In:

Corner Code #

1. Public Land Survey

T 19N R 1W

D-13

T R

T R

T R

T R

2. Property Controlling  
in Section

S T R

S T R

3. Miscellaneous  
Property in Sec.

S T R

S T R

STATE OF MICHIGAN  
GLADWIN COUNTY  
FILED - Remonumentation

17 OCT 97 1:21 P.M.

BONNIE K. HOUSE  
REGISTER OF DEEDS

Register of Deeds Stamp & File Number

4. Lot No. \_\_\_\_\_, Recorded Plat \_\_\_\_\_  
5. Private Claims \_\_\_\_\_

	A	B	C	D	E	F	G	H	I	J	K	L	M
1													
2	6			5			4		3			2	1
3													
4	7			8			9		10			11	12
5													
6	18			17			16		15			14	13
7													
8	19			20			21		22			23	24
9													
10	30			29			28		27			26	25
11													
12	31			32			33		34			35	36
13													

I, MARK R. ROBISON, in a field survey on May 2, 19 97 do hereby state that under requirements of P.A. 74, Michigan P.A. of 1970, the corner points mentioned in lines 1 and 2 above were in conformance with regulations and rules therefore as required in the current manual of survey instructions of the United States Department of the Interior, Bureau of Land Management or by a decree of a Court of Law and /or that the corner points mentioned in lines 3, 4 and 5 above were in conformance with the rules of the Michigan Board of Land Surveyors or by a Decree of a Court of Law; established, re-established, monumented, recovered, found as expressed below:

NOTE: Not more than 2 corners, all in the same town and range, may be recorded on this certificate.

A. Description of original monument and accessories and/or subsequent restoration:  
1877 T. Gale Merrill  
Set Post  
Wit-(1)N60E 10 links 20" Hemlock  
(2)West 24 links 12" Beech  
1994 Lapham working drawing  
1996 Lapham survey  
Found 1/2" iron  
Wit-(3)N05E 44.80' 10" Maple  
(4)N65W 94.25' Power Pole  
(5)S05E 27.53' Power Pole  
(6)N55E 84.98' Maple Clump

APPROVED LAND CORNER  
P.A. 345 of 1990  
Gladwin County

Co. Rep. [Signature]  
Date 9/18/97

B. Description of corner evidence found and/or method applied in restoring or reestablishing corner:

Found 1/2" x 18" iron over 1 1/2" x 4' black pipe in centerline of county road opposite fence and survey line North. Found capped iron 33.00 ft. North. Set Gladwin County Re-mon in place of 4 ft. pipe.

See dossier for detailed report.

C. Description of monument for corner and accessories established to perpetuate locating the position of the corner:

D-13: Corner on township line, Section 32.  
Set 5/8" x 36" rered with Gladwin County Re-mon Cap marked P.S.#27458.


Witnesses:  
N05E 10" Maple, nail & tag, 44.80'  
N65W Power Pole, nail & tag, 94.25'  
S05E Power Pole, nail & tag, 27.53'  
N55E Maple Clump, nail & tag, 84.98'  
East, N 1/4 Cor., Sec. 5, T18N, R1W, Gladwin County Remon, P.S.#27458

SURVEY &  
REMONUMENTATION

JAN 08 1998

SECTION

Signed by [Signature]  
Surveyor's Michigan License No. 27458

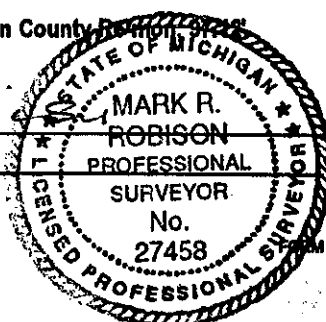

Date 10-7-97