

SURVEY & REMONUMENTATION

DEC 16 1996

GLADWIN COUNTY REMONUMENTATION

COMMISSION

LAND CORNER RECORDATION CERTIFICATE
Filing Requirement of Act 74, Mich. P.A. 1970

LIBER 001 PAGE 111

For corners in

GLADWIN (County)	Located In:	Corner Code #
1. Public Land Survey	T 19N R 1W	E - 11
	T R	
	T R	
	T R	
2. Property Controlling in Section	S T R	
	S T R	
3. Miscellaneous Property in Sec.	S T R	
	S T R	

STATE OF MICHIGAN
GLADWIN COUNTY
FILED-REMONUMENTATION

2 DEC 96 3:25 P.M.

BONNIE K. HOUSE
REGISTER OF DEEDS

Register of Deeds Stamp & File Number

4. Lot No. _____, Recorded Plat _____
5. Private Claims _____

I, MARK ROBISON, in a field survey on November, 1996 do hereby state that under requirements of P.A. 74, Michigan P.A. of 1970, the corner points mentioned in lines 1 and 2 above were in conformance with regulations and rules therefore as required in the current manual of survey instructions of the United States Department of the Interior, Bureau of Land Management or by a decree of a Court of Law and /or that the corner points mentioned in lines 3, 4 and 5 above were in conformance with the rules of the Michigan Board of Land Surveyors or by a Decree of a Court of Law; established, re-established, monumented, recovered, found as expressed below:

NOTE: Not more than 2 corners, all in the same town and range, may be recorded on this certificate.

	A	B	C	D	E	F	G	H	I	J	K	L	M
1													
2	6		5		4		3		2		1		
3													
4	7		8		9		10		11		12		
5													
6	18		17		16		15		14		13		
7													
8	19		20		21		22		23		24		
9													
10	30		29		28		27		26		25		
11													
12	31		32		33		34		35		36		
13													

A. Description of original monument and accessories and/or subsequent restoration:

1877 T. GALE MERRILL
SET COR. POST
WIT.-(1)HEMLOCK 12 S38W 41
(2)CEDAR 16 N27E 07

1908 KNOX SURVEY
FOUND CORNER

1994 PAUL LAPHAM SURVEY
SET C.I. FROM SEC. SUBD.
WIT.-(8)N15E 70.35 N&T MAPLE CLUMP
(9)N15W 39.53 N&T 8" BIRCH
(10)S50E 79.10 N&T MAPLE CLUMP
(11)S45W 56.50 N&T 16 MAPLE

1900 DOANE SURVEY
FOUND PINE STUMP OF B.L. AND
PLANTED POST 3" X 3" X 3"
WIT.-(3)USBT PINE STUMP 40" N45E 42 LKS
(4)USBT PINE STUMP 24" N86W 52"

1984 PAUL LAPHAM L.C.R.C. #284
FOUND 1/2" REROD
WIT.-(5)N45W C. MAPLE 45.17
(6)S10E 10" MAPLE 40.25
(7)N10E 3" BIRCH 30 SOUTH

1995 PAUL LAPHAM SURVEY
WIT.-NONE

1994 PAUL LAPHAM-WORKING DRAWING

B. Description of corner evidence found and/or method applied in restoring or reestablishing corner:

FOUND 1/2" IRON SET BY JOHN MEYER IN 1979; CORNER FOUND TO BE IN ERROR--DID NOT USE. FOUND C.I. IN C/L EAST & WEST COUNTY ROAD, SET BY JOHN MEYER IN 1995, USED AS CORNER OF RECORD. FOUND (8),(9),(10)&(11)--REC. & MEAS. SET GLADWIN RE-MON FROM FOUND IRON.

APPROVED LAND CORNER

P.A. 347 of 1900
Gladwin County

Co. Rep.


Date

SEE DOSSIER FOR DETAILED REPORT.

C. Description of monument for corner and accessories established to perpetuate locating the position of the corner:

E-11: CORNER COMMON TO SECTIONS 28, 29, 32 & 33
SET 5/8" X 3/8" REROD WITH GLADWIN RE-MON CAP MARKED P.S.#27458

WITNESSES:
N15E 70.35' N&T MAPLE CLUMP
N15W 39.53' N&T 8" BIRCH
S50E 79.10' N&T MAPLE CLUMP
S45W 56.50' N&T 16 MAPLE

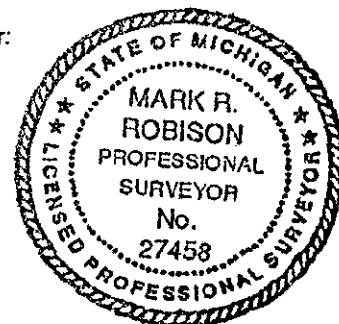

Signed by

Mark R. Robison

Date

11-29-96

Surveyor's Michigan License No. 27458