

GLADWIN COUNTY REMONUMENTATION

LIBER 001 PAGE 187

LAND CORNER RECORDATION CERTIFICATE  
Filing Requirement of Act 74, Mich. P.A. 1970

STATE OF MICHIGAN  
GLADWIN COUNTY  
FILED - Remonumentation

17 OCT 97 1:22 P.M.

BONNIE K. HOUSE  
REGISTER OF DEEDS

For corners in

GLADWIN

(County)

Located In:

Corner Code #

1. Public Land Survey

T 19N R 1W E-13

T \_\_\_\_\_ R \_\_\_\_\_

T \_\_\_\_\_ R \_\_\_\_\_

T \_\_\_\_\_ R \_\_\_\_\_

2. Property Controlling in Section

S \_\_\_\_\_ T \_\_\_\_\_ R \_\_\_\_\_

S \_\_\_\_\_ T \_\_\_\_\_ R \_\_\_\_\_

3. Miscellaneous Property in Sec.

S \_\_\_\_\_ T \_\_\_\_\_ R \_\_\_\_\_

S \_\_\_\_\_ T \_\_\_\_\_ R \_\_\_\_\_

4. Lot No. \_\_\_\_\_, Recorded Plat \_\_\_\_\_

5. Private Claims \_\_\_\_\_

Register of Deeds Stamp & File Number

I, MARK R. ROBISON, in a field survey on May 2, 19 97, do hereby state that under requirements of P.A. 74, Michigan P.A. of 1970, the corner points mentioned in lines 1 and 2 above were in conformance with regulations and rules therefore as required in the current manual of survey instructions of the United States Department of the Interior, Bureau of Land Management or by a decree of a Court of Law and/or that the corner points mentioned in lines 3, 4 and 5 above were in conformance with the rules of the Michigan Board of Land Surveyors or by a Decree of a Court of Law, established, re-established, monumented, recovered, found as expressed below:

NOTE: Not more than 2 corners, all in the same town and range, may be recorded on this certificate.

A. Description of original monument and accessories and/or subsequent restoration:

1877 T. Gale Merrill  
Set Post  
Wit.-(1)N28W 58 links 14" Pine  
(2)N44E 61 links 12" Maple  
1977 Lapham working drawing  
Found 1" iron  
Wit.-(3)S30W 8" Pine 49.13'  
(4)S10W 4" Pine 83.50'  
(5)S40E 5" Pine 60.76'  
(6)S85E 1/4" R.R. 134.65'

1979 Lapham working drawing  
1981 Lapham survey  
Wit.-same as (3),(4)&(5)  
1982 Lapham L.C.R.C.#261  
Wit.-same as (3),(4)&(5)  
1985 Lapham survey  
Wit.-same as (3),(4)&(5)

1994 Lapham working drawing

1996 Lapham survey  
Found 1/2" rod  
Wit.-(7)N10E 63.40' - 10" Cherry  
(8)N30W 60.08' - 8" Ash  
(9)S20E 60.97' - 8" Pine  
(10)S30W 49.10' - 18" Pine

B. Description of corner evidence found and/or method applied in restoring or reestablishing corner:

Found 1/2" x 18" iron over 1/2" x 14" iron 2 ft. below surface in centerline of county road opposite survey line to North. Found witness (4); measured 83.6' +/- to centerline of 12" Pine (no markings), recorded 83.5'. Found witness (5); measured 60.8' +/- to center of 12" Pine (no markings), recorded 60.76'. Set Gladwin County Re-mon in place of found iron.

GLO recorded 114.84, measured 134.65

See dossier for detailed report.

APPROVED LAND CORNER  
P.A. 345 of 1990  
Gladwin County

Co. Rep. [Signature]  
Date 9/18/97

C. Description of monument for corner and accessories established to perpetuate locating the position of the corner:

E-13: Corner on township line, common to sections 32 & 33.  
Set 5/8" x 36" rod with Gladwin County Re-mon Cap marked P.S.#27458.  
Witnesses:  
N10E 10" Cherry, nail & tag, 63.40'  
N30W 8" Ash, nail & tag, 60.08'  
S20E 8" Pine, nail & tag, 60.97'  
S30W 18" Pine, nail & tag, 49.10'  
East, NE Cor., Section 5, T18N, R1W, Gladwin County Remon #27458

SURVEY &  
REMONUMENTATION


JAN 08 1998

SECTION

Signed by

[Signature]

Surveyor's Michigan License No. 27458

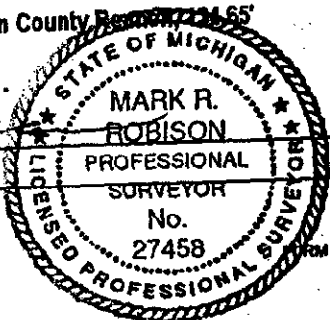

Date

10-7-97