

GLADWIN COUNTY REMONUMENTATION

LAND CORNER RECORDATION CERTIFICATE  
 Filing Requirement of Act 74, Mich. P.A. 1970

LIBER 001 PAGE 188

For corners in

GLADWIN Located In: \_\_\_\_\_ Corner Code # \_\_\_\_\_  
 (County)

1. Public Land Survey T 19N R 1W F - 13  
 T \_\_\_\_\_ R \_\_\_\_\_  
 T \_\_\_\_\_ R \_\_\_\_\_  
 T \_\_\_\_\_ R \_\_\_\_\_

2. Property Controlling S \_\_\_\_\_ T \_\_\_\_\_ R \_\_\_\_\_  
 in Section S \_\_\_\_\_ T \_\_\_\_\_ R \_\_\_\_\_

3. Miscellaneous S \_\_\_\_\_ T \_\_\_\_\_ R \_\_\_\_\_  
 Property in Sec. S \_\_\_\_\_ T \_\_\_\_\_ R \_\_\_\_\_

4. Lot No. \_\_\_\_\_, Recorded Plat \_\_\_\_\_  
 5. Private Claims \_\_\_\_\_

STATE OF MICHIGAN  
 GLADWIN COUNTY  
 FILED - Remonumentation

17 OCT 97 1:22 P.M.

BONNIE K. HOUSE  
 REGISTER OF DEEDS

Register of Deeds Stamp & File Number

I, MARK R. ROBISON, in a field survey on May 22, 19 97 do hereby state that under requirements of P.A. 74, Michigan P.A. of 1970, the corner points mentioned in lines 1 and 2 above were in conformance with regulations and rules therefore as required in the current manual of survey instructions of the United States Department of the Interior, Bureau of Land Management or by a decree of a Court of Law and/or that the corner points mentioned in lines 3, 4 and 5 above were in conformance with the rules of the Michigan Board of Land Surveyors or by a Decree of a Court of Law, established, re-established, monumented, recovered, found as expressed below:

NOTE: Not more than 2 corners, all in the same town and range, may be recorded on this certificate.

|    | A | B  | C | D  | E | F  | G | H  | I | J  | K | L  | M |
|----|---|----|---|----|---|----|---|----|---|----|---|----|---|
| 1  |   |    |   |    |   |    |   |    |   |    |   |    |   |
| 2  |   | 6  |   | 5  |   | 4  |   | 3  |   | 2  |   | 1  |   |
| 3  |   |    |   |    |   |    |   |    |   |    |   |    |   |
| 4  |   | 7  |   | 8  |   | 9  |   | 10 |   | 11 |   | 12 |   |
| 5  |   |    |   |    |   |    |   |    |   |    |   |    |   |
| 6  |   | 16 |   | 17 |   | 16 |   | 15 |   | 14 |   | 13 |   |
| 7  |   |    |   |    |   |    |   |    |   |    |   |    |   |
| 8  |   | 19 |   | 20 |   | 21 |   | 22 |   | 23 |   | 24 |   |
| 9  |   |    |   |    |   |    |   |    |   |    |   |    |   |
| 10 |   | 30 |   | 29 |   | 28 |   | 27 |   | 26 |   | 25 |   |
| 11 |   |    |   |    |   |    |   |    |   |    |   |    |   |
| 12 |   | 31 |   | 32 |   | 33 |   | 34 |   | 35 |   | 36 |   |
| 13 |   |    |   |    |   |    |   |    |   |    |   |    |   |

A. Description of original monument and accessories and/or subsequent restoration:

- 1877 T. Gale Merrill 1979 Lapham survey  
Set Post
- Wit.-(1)N6E 37 links 10" Hemlock 1979 Lapham working dwg.  
(2)N45E 47 links 10" Cedar
- 1977 Lapham - field notes 1982 Lapham L.C.R.C.#281  
Set 1/2" rerod-set iron C/L road Found iron pipe  
opposite fence to North
- Wit.-(3)North Fence Corner 23.25' (7)North Fe Cor 22.80'  
(4)N50W 8" Poplar 59.86' (8)N15E 12" Poplar 24.80'  
(5)S10W 6" Poplar 24.37' (9)S45E 6" Ash 26.70'  
(6)East 1/2" rerod 121.05'
- 1994 Lapham - 3 working dwgs.

B. Description of corner evidence found and/or method applied in restoring or reestablishing corner:

Found 1/2" x 18" rerod in centerline of road opposite brush line to North, 18" below surface. Found (6); recorded & measured 121.05'. Set Gladwin County Re-mon in place of found iron.

See dossier for detailed report.

APPROVED LAND CORNER  
 P.A. 845 of 1990  
 Gladwin County


Co. Rep. [Signature]  
 Date 6/10/97

C. Description of monument for corner and accessories established to perpetuate locating the position of the corner:

F-13: Corner on township line, Section 33.  
 Set 5/8" x 36" rerod with Gladwin County Re-mon Cap marked P.S.#27458.

- Witnesses:
- N35E 6" Ash, nail & tag, 41.55'
  - N40W 10" Poplar, nail & tag, 71.47'
  - S45W 10" Oak, nail & tag, 83.20'
  - S45E 6" Spruce, nail & tag, 62.15'
  - East, N 1/4 Corner, Section 4, T18N, R1W, 121.05'

Signed by [Signature]  
 Surveyor's Michigan License No. 27458

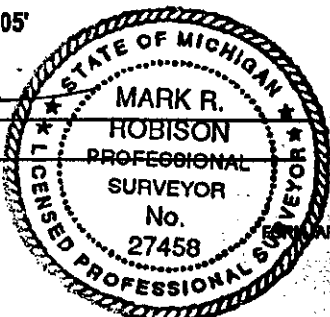

Date 10-7-97

SURVEY &  
 REMONUMENTATION

JAN 08 1998

SECTION