

**SURVEY & REMONUMENTATION**

DEC 16 1996

COMMISSION

GLADWIN COUNTY REMONUMENTATION

**LAND CORNER RECORDATION CERTIFICATE**  
Filing Requirement of Act 74, Mich. P.A. 1970

LIBER **001** PAGE **113**

For corners in

GLADWIN (County)	Located In:	Corner Code #
1. Public Land Survey	T 19N R 1W	G - 11
	T R	
	T R	
	T R	
2. Property Controlling in Section	S T R	
	S T R	
3. Miscellaneous Property in Sec.	S T R	
	S T R	

STATE OF MICHIGAN  
GLADWIN COUNTY  
FILED-REMONUMENTATION

2 DEC 96 3:26 P.M.

RONNIE K. HOUSE  
REGISTER OF DEEDS

Register of Deeds Stamp & File Number

4. Lot No. \_\_\_\_\_, Recorded Plat \_\_\_\_\_  
5. Private Claims \_\_\_\_\_

I, MARK ROBISON, in a field survey on November, 1996 do hereby state that under requirements of P.A. 74, Michigan P.A. of 1970, the corner points mentioned in lines 1 and 2 above were in conformance with regulations and rules therefore as required in the current manual of survey instructions of the United States Department of the Interior, Bureau of Land Management or by a decree of a Court of Law and /or that the corner points mentioned in lines 3, 4 and 5 above were in conformance with the rules of the Michigan Board of Land Surveyors or by a Decree of a Court of Law; established, re-established, monumented, recovered, found as expressed below:

NOTE: Not more than 2 corners, all in the same town and range, may be recorded on this certificate.

	A	B	C	D	E	F	G	H	I	J	K	L	M
1													
2	6		5		4		3		2		1		
3													
4	7		8		9		10		11		12		
5													
6	18		17		16		15		14		13		
7													
8	19		20		21		22		23		24		
9													
10	30		29		28		27		26		25		
11													
12	31		32		33		34		35		36		
13													

A. Description of original monument and accessories and/or subsequent restoration:

1877 T. GALE MERRILL SET POST	FOUND 1/2" IRON
WIT.-(1)HEMLOCK 13 S71E 13	WIT.-(5)N45W P.P. 47.40
(2)MAPLE 14 N46W 31	(6)N48E N END 12" CMD 42.3
1908 KNOX SURVEY FOUND STAKE	(7)S48E S END 12" CMD 40.6
1950 DUNDAS	1985 PAUL LAPHAM SURVEY
NO CORNER MATERIAL	WIT.-SAME AS (5),(6),&(7)
WIT.-(3)SW FE. POST 50	1993 PAUL LAPHAM-WORKING DRAWING
(4)NE STOP SIGN 36.6	1993 PAUL LAPHAM SURVEY
1979 PAUL LAPHAM-SEC. SUBD.	WIT.-SAME AS (5),(6),&(7)
NO CORNER WITNESSES	1994 PAUL LAPHAM-WORKING DRAWING
1982 PAUL LAPHAM L.C.R.C. #281	1994 PAUL LAPHAM SURVEY

WIT.-SAME AS (5),(6),&(7)

APPROVED LAND CORNER  
P.A. 74 OF 1970  
Gladwin County

Co. Rep. Mark Robison  
Date 11/6/96

B. Description of corner evidence found and/or method applied in restoring or reestablishing corner:


FOUND BOLT SPIKE IN PATCH IN C/L OF CROSROADS, 0.5 BELOW SURFACE OF ASPHALT ROAD. FOUND WITNESS (5); REC. 47.4, MEAS. 47.41. SET GLADWIN RE-MON FROM FOUND CORNER AND WITNESS (5).

SEE DOSSIER FOR DETAILED REPORT.

C. Description of monument for corner and accessories established to perpetuate locating the position of the corner:

G-11: CORNER COMMON TO SECTIONS 27, 28, 33 & 34  
SET 5/8" X 36" REROD IN MON BOX WITH GLADWIN RE-MON CAP MARKED P.S.#27458

WITNESSES:  
N45W POWER POLE N&T 47.41'      N55W 8" PINE, N&T, 63.94'  
S40E CLUMP 4" MAPLES N&T 108.72'      NORTH, P.K. NAIL, 2.0'  
S45W POWER POLE, N&T, 49.12'      EAST, P.K. NAIL, 2.0'  
N25E TWIN 12" PINE, N&T, 111.12'

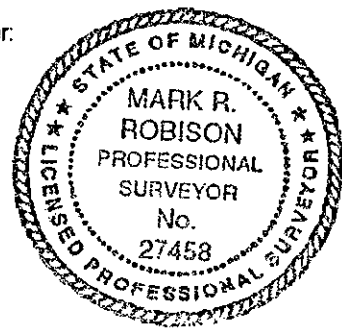

Signed by Mark Robison  
Surveyor's Michigan License No. 27458

Date 11-29-96