

**GLADWIN COUNTY REMONUMENTATION**

**LAND CORNER RECORDATION CERTIFICATE**  
Filing Requirement of Act 74, Mich. P.A. 1970

LIBER **001** PAGE **189**

For corners in

<u>GLADWIN</u> (County)	Located In:	Corner Code #
1. Public Land Survey	T <u>19N</u> R <u>1W</u>	<u>H-13</u>
	T _____ R _____	_____
	T _____ R _____	_____
	T _____ R _____	_____
2. Property Controlling in Section	S _____ T _____ R _____	_____
	S _____ T _____ R _____	_____
3. Miscellaneous Property in Sec.	S _____ T _____ R _____	_____
	S _____ T _____ R _____	_____
4. Lot No. _____, Recorded Plat _____		
5. Private Claims _____		

STATE OF MICHIGAN  
GLADWIN COUNTY  
FILED - Remonumentation

17 OCT 97 1:22 P.M.

BONNIE K. HOUSE  
REGISTER OF DEEDS  
Register of Deeds Stamp & File Number

I, MARK R. ROBISON, in a field survey on May 2, 19 97 do hereby state that under requirements of P.A. 74, Michigan P.A. of 1970, the corner points mentioned in lines 1 and 2 above were in conformance with regulations and rules therefore as required in the current manual of survey instructions of the United States Department of the Interior, Bureau of Land Management or by a decree of a Court of Law and /or that the corner points mentioned in lines 3, 4 and 5 above were in conformance with the rules of the Michigan Board of Land Surveyors or by a Decree of a Court of Law; established, re-established, monumented, recovered, found as expressed below:

NOTE: Not more than 2 corners, all in the same town and range, may be recorded on this certificate.

A	B	C	D	E	F	G	H	I	J	K	L	M
1												
2	6	5	4	3	2	1						
3												
4	7	8	9	10	11	12						
5												
6	18	17	16	15	14	13						
7												
8	19	20	21	22	23	24						
9												
10	30	29	28	27	26	25						
11												
12	31	32	33	34	35	36						
13												

A. Description of original monument and accessories and/or subsequent restoration:

1877 T. Gale Merrill Set Post Wit.-(1)N73W 18 links 8" Hemlock (2)N6W 14 links 18" Maple	1985 Lapham survey Found 1/2" iron Wit.-(3)North Fence Cor. 24.40' (4)S20W 5" Poplar 30.30' (5)N40W Fence Post 32.40'
1980 Lapham survey notes Found 1/2" iron	1993 Lapham working drawing

APPROVED LAND CORNER  
P.A. 345 of 1990  
Gladwin County

Co./Rep. [Signature]  
Date 9/18/97

B. Description of corner evidence found and/or method applied in restoring or reestablishing corner:  
Found 1/2" x 18" rered in centerline of county road opposite old fence to North. Set Gladwin County Re-mon in place of found 1/2" x 18" rered.

See dossier for detailed report.

C. Description of monument for corner and accessories established to perpetuate locating the position of the corner:


H-13: Corner on township line, Section 34.  
Set 5/8" x 36" rered with Gladwin County Re-mon Cap marked P.S.#27458.  
Witnesses:  
N20W Power Pole, nail & tag, 54.80'  
South, 1/2" x 36" rered, 33.00'  
North 1/2" x 36" rered, 33.00'  
North, Fence Corner (spike) 35.60'  
East, N 1/4 Sec. 3, T18N, R1W, Gladwin County Re-mon, 99.20'

SURVEY &  
REMONUMENTATION

JAN 08 1998

SECTION

Signed by [Signature]  
Surveyor's Michigan License No. 27458

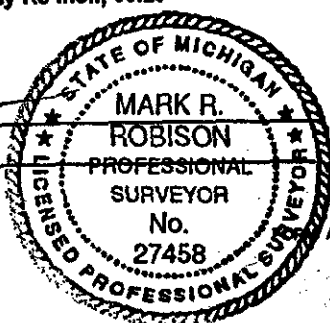

Date 10-7-97