

SURVEY & REMONUMENTATION
GLADWIN COUNTY REMONUMENTATION PROGRAM

PAGE 02

DEC 29 '93 AM


FEB 18 1994

LAND CORNER RECORDATION CERTIFICATE
Filing Requirement of Act 74, Mich. P.A. 1970

For corners in COMMISSION
GLADWIN
 (County)

Located In: _____ Corner Code # _____

1. Public Land Survey	T	<u>19N</u>	R	<u>1W</u>	<u>M-7</u>
	T	_____	R	_____	_____
	T	_____	R	_____	_____
	T	_____	R	_____	_____
2. Property Controlling in Section	S	_____	T	_____	R
	S	_____	T	_____	R
3. Miscellaneous Property in Sec.	S	_____	T	_____	R
	S	_____	T	_____	R

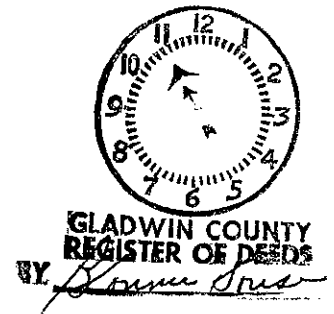

Register of Deeds Stamp & File Number

4. Lot No. _____, Recorded Plat _____
 5. Private Claims _____

	A	B	C	D	E	F	G	H	I	J	K	L	M
2	6	5	4	3	2	1							
3													
4	7	8	9	10	11	12							
5													
6	18	17	16	15	14	13							
7													
8	19	20	21	22	23	24							
9													
10	30	29	28	27	26	25							
11													
12	31	32	33	34	35	36							
13													

I, PAUL B. LAPHAM, in a field survey on OCTOBER, 19 93, do hereby certify that under requirements of P.A. 74, Michigan P.A. of 1970, the corner points mentioned in lines 1 and 2 above were in conformance with regulations and rules therefore as required in the current manual of survey instructions of the United States Department of the Interior, Bureau of Land Management or by a decree of a Court of Law and/or that the corner points mentioned in lines 3, 4 and 5 above were in conformance with the rules of the Michigan Board of Land Surveyors or by a Decree of a Court of Law, established, re-established, monumented, re-monumented, recovered, found as expressed below:

NOTE: Not more than 4 corners, all in the same town and range, may be recorded on this certificate.

A. Description of original monument and accessories and/or subsequent restoration:

- 1877 T. MERRILL, SET CORNER IN STREAM
 - BALSAM, 10" S 76°W, 65 LKS P. 569-558
 - HEMLOCK, 8" N 79-1/2°W 84 LKS
- 1961 GILBERT, 3/4" ROD, M.S.H.D. WITNESS CARD
 - N 11°W, 32.86' - 4" ASH
 - N 85°E, 70.52' - 11" ELM
 - SOUTH, 19.85' - 6" POPLAR
- 01-84 C.E. OSTLING, (132) 002-214
- 01-14-92 ROSER, LCRC #333

B. Description of corner evidence found and/or method applied in restoring or reestablishing corner:

- FOUND D.N.R. MONUMENT IN EDGE OF RIVER (1" PIPE W/ D.N.R. MONUMENT CAP).
- FOUND RECORDED WITNESSES:
 - N 30°E, 47.8' - 8" TWIN IRONWOOD
 - S 55°E, 59.2' - 16" CEDAR
 - S 30°W, 69.7' - 5" WHITE PINE
 - N 83°W, 48.2' - 7" ASH

NOTED THAT SURVEYOR ROSER RE-TRACED 1-84 OSTLING SURVEY TO RE-SET CORNER IN RIVER. ROSER STATES THAT THE GILBERT CORNER (1961) IS IN ERROR, 130± TO FAR WEST. G.L.O. NOTES SAY CORNER FALLS IN RIVER. THIS FITS D.N.R. MONUMENT AND OSTLING SURVEY.

This Corner established in Gladwin County Remonumentation Program.
 See dossier for detailed report.

C. Description of monument for corner and accessories established to perpetuate locating the position of the corner:

- ACCEPTED D.N.R. MONUMENT - 1" x 8' GALV. PIPE W/ ALUMINUM D.N.R. CAP
 - N 30°E, 47.8' - 8" TWIN IRONWOOD
 - S 55°E, 59.2' - 16" CEDAR
 - S 30°W, 69.7' - 5" WHITE PINE
 - N 83°W, 48.2' - 7" ASH



Signed by Paul B. Lapham Date 12-08-93
 Surveyor's Michigan License No. 9433