


FEB 18 1994

LAND CORNER RECORDATION CERTIFICATE
Filing Requirement of Act 74, Mich. P.A. 1970

DEC 29 '93 AM

COMMISSION
For corners in

GLADWIN (County)	Located In:	Corner Code #
1. Public Land Survey	T <u>19N</u> R <u>1W</u>	<u>M-9</u>
	T _____ R _____	_____
	T _____ R _____	_____
	T _____ R _____	_____
2. Property Controlling in Section	S _____ T _____ R _____	_____
	S _____ T _____ R _____	_____
3. Miscellaneous Property in Sec.	S _____ T _____ R _____	_____
	S _____ T _____ R _____	_____

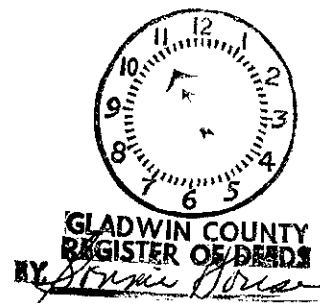

Register of Deeds Stamp & File Number

4. Lot No. _____, Recorded Plat _____
5. Private Claims _____

I, PAUL B. LAPHAM, in a field survey on OCTOBER, 19 93, do hereby certify that under requirements of P.A. 74, Michigan P.A. of 1970, the corner points mentioned in lines 1 and 2 above were in conformance with regulations and rules therefore as required in the current manual of survey instructions of the United States Department of the Interior, Bureau of Land Management or by a decree of a Court of Law and/or that the corner points mentioned in lines 3, 4 and 5 above were in conformance with the rules of the Michigan Board of Land Surveyors or by a Decree of a Court of Law; established, re-established, monumented, re-monumented, recovered, found as expressed below:

	A	B	C	D	E	F	G	H	I	J	K	L	M
2	6		5		4		3		2		1		
3													
4	7		8		9		10		11		12		
5													
6	18		17		16		15		14		13		
7													
8	19		20		21		22		23		24		
9													
10	30		29		28		27		26		25		
11													
12	31		32		33		34		35		36		
13													

NOTE: Not more than 4 corners, all in the same town and range, may be recorded on this certificate.

- A. Description of original monument and accessories and/or subsequent restoration:
 1833 T. MERRILL, POST, W. PINE 24" S 73°W, 10 LKS P.557
 W. PINE 18" N 05°W, 22 LKS
 03-07-61 GILBERT, 3/4" ROD IN MON. BOX, M.S.H.D. WITNESS CARD
 S 76°W, 109.31' - 13" ELM
 S 48°30'W, 136.10' - 11" BIRCH
 S 08°E, 246.42' - 7" J. PINE

- B. Description of corner evidence found and/or method applied in restoring or reestablishing corner:
 FOUND 3/4" IRON IN MSHD MON. BOX. EXCAVATED TO DEPTH OF 3 FEET. DID NOT FIND ADDITIONAL EVIDENCE.
 FOUND NO RECORDED WITNESSES.

This Corner established in Gladwin County Remonumentation Program.
See dossier for detailed report.

- C. Description of monument for corner and accessories established to perpetuate locating the position of the corner:
 SET 5/8" X 36" RE-ROD WITH 2" GLADWIN COUNTY MONUMENT CAP IN MONUMENT BOX.
 N 41°W, 37.88' - NORTH TOP CENTER, 24" C.M.P.
 S 60°W, 45.02' - SOUTH TOP CENTER, 24" C.M.P.
 N 40°W, 88.54' - POWER POLE
 S 75°E, 48.86' - 14" RED PINE



Signed by Paul B. Lapham Date 12/00/93
 Surveyor's Michigan License No. 9433