


FEB 18 1994

LAND CORNER RECORDATION CERTIFICATE
Filing Requirement of Act 74, Mich. P.A. 1970

DEC 29 93 AM

For corners in COMMISSION

Form with fields for County (GLADWIN), Located in, Corner Code (M-11), and numbered sections 1-5 for survey details.

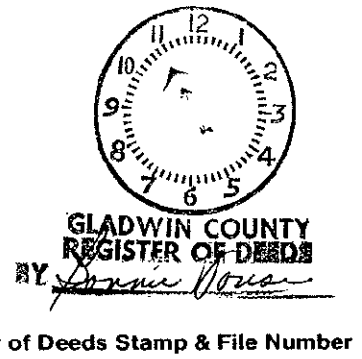

4. Lot No. , Recorded Plat
5. Private Claims

Grid table with columns A-M and rows 2-13, containing numerical values for recording.

I, PAUL B. LAPHAM, in a field survey on OCTOBER, 19 93, do hereby certify that under requirements of P.A. 74, Michigan P.A. of 1970, the corner points mentioned in lines 1 and 2 above were in conformance with regulations and rules therefore as required in the current manual of survey instructions of the United States Department of the Interior, Bureau of Land Management or by a decree of a Court of Law and/or that the corner points mentioned in lines 3, 4 and 5 above were in conformance with the rules of the Michigan Board of Land Surveyors or by a Decree of a Court of Law; established, re-established, monumented, re-monumented, recovered, found as expressed below:

NOTE: Not more than 4 corners, all in the same town and range, may be recorded on this certificate.

- A. Description of original monument and accessories and/or subsequent restoration:
1877 T. MERRILL, POST, BEECH 11" S 70°W, 18 LKS
MAPLE 10" S 25°W, 11 LKS
03-06-61 GILBERT, 1" IRON PIPE IN MON. BOX, M.S.H.D. WITNESS CARD
N 61°W, 46.89' - CH. X N.E. COR. HDWL.
S 65°W, 45.89' - CH. X S.E. COR. HDWL.
N 71°E, 88.90' - 15" APPLE
S 55°E, 92.07' - 11" APPLE
12-17-62 LAPHAM, MONUMENT BOX, N.E. CORNER SEC. 36, UNRECORDED SURVEY & NOTES
08-28-78 McGINNIS, MONUMENT BOX, (132) 1-301
08-16-83 MEYERS, MONUMENT BOX, UNRECORDED SURVEY

- B. Description of corner evidence found and/or method applied in restoring or reestablishing corner:
FOUND 1" x 36" IRON PIPE IN MON. BOX. EXCAVATED TO DEPTH OF 3-1/2 FEET, FOUND 3/4"± PIPE IN BOTTOM OF HOLE, COUND NOT EXCAVATE PIPE, LEFT PIPE IN PLACE.
FOUND RECORDED WITNESSES:
S.W., 87.92' - POWER POLE
S.E., 83.7' - TELE. POLE

This Corner established in Gladwin County Remonumentation Program. See dossier for detailed report.

- C. Description of monument for corner and accessories established to perpetuate locating the position of the corner:
SET 5/8" X 36" RE-ROD WITH 2" GLADWIN COUNTY MONUMENT CAP IN MONUMENT BOX.
N 60°W, 46.10' - S.E. CORNER, N.W. HEADWALL
S 70°W, 45.50' - N.E. CORNER, S.W. HEADWALL
S 50°W, 88.39' - SPIKE, S.E. SIDE, ELECT. POLE
S 45°E, 84.16' - SPIKE, N.E. SIDE TELE. POLE



Signed by Paul B. Lapham Date 12/08/93
Surveyor's Michigan License No. 9433