

**LAND CORNER RECORDATION CERTIFICATE**  
**Filing Requirement of Act 74, Mich. P.A. 1970**

For corners in  
**GLADWIN**

(County)

Located In:

Corner Code **H-7**

- |                                    |   |            |   |           |            |
|------------------------------------|---|------------|---|-----------|------------|
| 1. Public Land Survey              | T | <u>19N</u> | R | <u>1W</u> | <u>H-7</u> |
|                                    | T |            | R |           |            |
|                                    | T |            | R |           |            |
|                                    | T |            | R |           |            |
| 2. Property Controlling in Section | S |            | T | R         |            |
|                                    | S |            | T | R         |            |
| 3. Miscellaneous                   | S |            | T | R         |            |
| Property in Sec.                   | S |            | T | R         |            |

Register of Deeds Stamp & File Number

4. Lot No. \_\_\_\_\_, Recorded Plat \_\_\_\_\_  
 5. Private Claims \_\_\_\_\_

I, C.F. ROSER, in a field survey on 04-04, 19 90, do hereby certify that under requirements of P.A. 74, Michigan P.A. of 1970, the corner points mentioned in lines 1 and 2 above were in conformance with regulations and rules therefore as required in the current manual of survey instructions of the United States Department of the Interior, Bureau of Land Management or by a decree of a Court of Law and/or that the corner points mentioned in lines 3, 4 and 5 above were in conformance with the rules of the Michigan Board of Land Surveyors or by a Decree of a Court of Law; established, re-established, monumented, re-monumented, recovered, found as expressed below:

**NOTE: Not more than 4 corners, all in the same town and range, may be recorded on this certificate.**

A. Description of original monument and accessories and/or subsequent restoration:  
**H-7**


B. Description of corner evidence found and/or method applied in restoring or reestablishing corner:

**H-7**  
 RESTORED SE COR OF SEC 13,  
 T19N-R1W. (ON HIGH MERIDIAN)  
 ON LINE AND DOUBLE DISTANCE  
 ACROSS FOUND 1/8 COR & 1/4 COR  
 TO WEST. COR FALLS JUST INTO  
 RIVER AT E'LY EDGE. OLD CALLS  
 FOR COR IN RV. TOP OF PIPE IS  
 4' ABOVE TOP OF WATER (ON  
 7-31-90) AND 1' ABOVE THE  
 GROUND AT THE STEEP SIDE BANK  
 AT RV'S EDGE.

C. Description of monument for corner and accessories established to perpetuate locating the position of the corner:

**H-7**  
 DROVE 1" x 8" GALV. PIPE W/ALUM  
 BNR CAP & BET CEDAR POST.  
 8"TM. IRONWOOD N30°E 47.8'  
 16" CEDAR S35°E 59.2'  
 5" W. PINE S30°W 69.7'  
 7" ASH N83°W 48.2'

	A	B	C	D	E	F	G	H	I	J	K	L	M
2	6	5	4	3	2	1							
3													
4	7	8	9	10	11	12							
5													
6	18	17	16	15	14	13							
7													
8	19	20	21	22	23	24							
9													
10	30	29	28	27	26	25							
11													
12	31	32	33	34	35	36							
13													

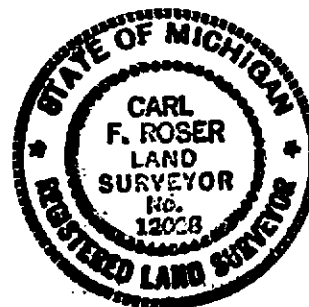

Signed by Carl F. Roser Date 01-14-92

Surveyor's Michigan License No. 12028