

# LAND CORNER RECORDATION CERTIFICATE

Filing Requirement of Act 74, Mich. PA 1970

For Corners In: Gladwin Located In \_\_\_\_\_ Corner Code # \_\_\_\_\_  
(County)

1. Public Land Survey	T	<u>19N</u>	R	<u>2E</u>	<u>M2</u>
	T	_____	R	_____	_____
2. Property Controlling in Section	S	_____	T	_____	R
	S	_____	T	_____	R
3. Miscellaneous Property in Section	S	_____	T	_____	R
	S	_____	T	_____	R

4. Lot No: \_\_\_\_\_ Recorded Plat: \_\_\_\_\_

5. Private Claims: \_\_\_\_\_

I, Craig W. McVean, in a field survey on Feb. 22, 2005 do hereby state that under requirements of PA 74, Michigan PA of 1970, the corner points mentioned in lines 1 and 2 above were in conformance with regulations and rules therefore as required in the current manual of survey instructions of the United States Department of the Interior, Bureau of Land Management or by a decree of a Court of Law and/or that the corner points mentioned in lines 3, 4 and 5 above were in conformance with the rules of the Michigan Board of Land Surveyors or by a Decree of a Court of Law; established, re-established, monumented, recovered, found as expressed below:

**NOTE: Not more than 2 corners, all in the same town and range, may be recorded on this certificate.**

**A. Description of original monument and accessories and/or subsequent restoration:**


M2 – GLO – Set ¼ Post – L. Clason – 1837  
 Elm 8" N88°E 30 L.  
 Tamarack 12" S45°E 17 L.  
 - CCC Notes – 1930's - N. 440+00 CH. – Random  
 in marsh. ¼ Post is 7.71 E. and 1.37½ S. of Random  
 - CPC – Drawing #16944 – Sheet 98 – 1968  
 Set corner; 16" Maple N65°E 58.20'; 18" Maple S5°W 42.40'

**B. Description of corner evidence found and/or method applied in restoring or re-establishing corner:**

M2 – Standard ¼ Corner common to Sec. 6, T19N, R3E and Sec. 1, T19N, R2E. – No evidence found of either CCC or Consumer's corner positions in tag elder swamp. No GLO evidence. Set 4" DNR Alum. Cap on 1" x 5' long Galv. iron pipe by single proportion to GLO between 'M1' and 'M3'. DNR Mon. accepted as a careful and faithful re-establishment of the position of the original corner.

**C. Description of monument for corner and accessories established to perpetuate locating the position of the corner:**

M2 - 4" DNR Alum. Cap on 1" x 5' long galv. iron pipe.  
 Set Blue Carsonite Post 1' E.  
 S43°E 39.87' to set N & T in NE side 3" Ash  
 S81°E 28.97' to set N & T in N side 2" Ash  
 N21°W 46.38' to set ½" x 16" rebar  
 S85°W 39.75' to set 3/8" x 18" rebar

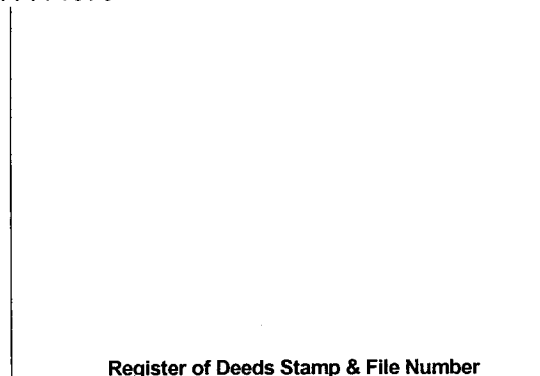

	A	B	C	D	E	F	G	H	I	J	K	L	M
1													
2	6		5		4		3		2		1		
3													
4	7		8		9		10		11		12		
5													
6	18		17		16		15		14		13		
7													
8	19		20		21		22		23		24		
9													
10	30		29		28		27		26		25		
11													
12	31		32		33		34		35		36		
13													

Signed by: Craig W. McVean  
 Surveyor's Michigan License No.: 39088

Date: 5/9/2007

