


# LAND CORNER RECORDATION CERTIFICATE

Filing Requirement of Act 74, Mich. PA 1970

For Corners In:  
Gladwin Located In \_\_\_\_\_ Corner Code # \_\_\_\_\_  
 (County)

- |                                      |   |     |   |    |    |
|--------------------------------------|---|-----|---|----|----|
| 1. Public Land Survey                | T | 19N | R | 2E | K1 |
|                                      | T |     | R |    |    |
| 2. Property Controlling in Section   | S | T   | R |    |    |
|                                      | S | T   | R |    |    |
| 3. Miscellaneous Property in Section | S | T   | R |    |    |
|                                      | S | T   | R |    |    |

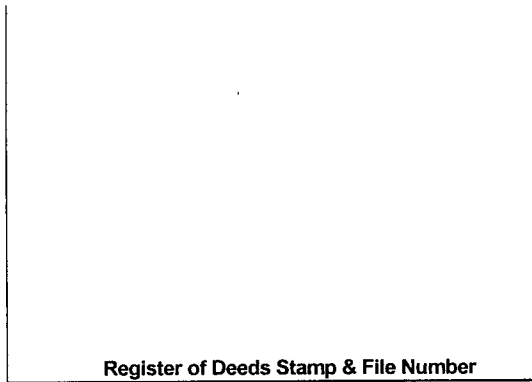

4. Lot No: \_\_\_\_\_ Recorded Plat: \_\_\_\_\_

5. Private Claims: \_\_\_\_\_

I, Craig W. McVean, in a field survey on May 3, 2005 do hereby state that under requirements of PA 74, Michigan PA of 1970, the corner points mentioned in lines 1 and 2 above were in conformance with regulations and rules therefore as required in the current manual of survey instructions of the United States Department of the Interior, Bureau of Land Management or by a decree of a Court of Law and/or that the corner points mentioned in lines 3, 4 and 5 above were in conformance with the rules of the Michigan Board of Land Surveyors or by a Decree of a Court of Law; established, re-established, monumented, recovered, found as expressed below:

**NOTE: Not more than 2 corners, all in the same town and range, may be recorded on this certificate.**

	A	B	C	D	E	F	G	H	I	J	K	L	M
1											●		
2	6			5		4		3		2		1	
3													
4	7		8		9		10		11		12		
5													
6	18		17		16		15		14		13		
7													
8	19		20		21		22		23		24		
9													
10	30		29		28		27		26		25		
11													
12	31		32		33		34		35		36		
13													

A. Description of original monument and accessories and/or subsequent restoration:

- K1 - GLO - Intersect Townline 10 L. East of section corner between 35 & 36 at T20N, R2E.  
 Set post at intersection - J. Mullett - 1846  
 Beech 8" S19°W 27 L.  
 Beech 7" S11°E 43 L.  
 - CCC Notes - 1930's - West on N. Bdy. of Sec. 1, T19N, R2E- 80:00 CH. Set random post. Sec. post is 49 N. & 9 L. E. of random. North random between Sec. 1 & 2- 477.83 CH. - Inter. townline 1.39 W. of W. post which is 10 L. W. of E. post.

B. Description of corner evidence found and/or method applied in restoring or re-establishing corner:

- K1 - Closing corner common to Sections 1 and 2, T19N, R2E - Fd. 2 - 1 1/2" x 4± long iron pipes lying in swamp in this area disturbed apparently by timbering operations. Couldn't recover old positions or any conclusive GLO evidence. Thus set stamped 4" DNR Aluminum cap on 1" x 6' galv. iron pipe by single proportion between re-established 'K13' - T20N, R2E and Fd. 'L13', T20N, R2E per standard BLM procedure at 6.59' East (6.6' - GLO) of 'K13'. DNR monument is accepted as a careful and faithful reestablishment of the position of the original corner.

C. Description of monument for corner and accessories established to perpetuate locating the position of the corner:

- K1 - A DNR 4" Aluminum cap on a 1" x 6' galv. iron pipe.  
 N42°E 76.73' to set N & T in SE side 28" Oak  
 S08°E 83.84' to set N & T in W side 4" Cherry  
 N76°W 179.28' to set N & T in N side 8" Maple  
 West 6.59' to 'K13', T20N, R2E - DNR Mon.  
 Set Blue Carsonite Post 1' South



Signed by: Craig W. McVean  
 Surveyor's Michigan License No.: 39088

Date: 5/9/2007