

LAND CORNER RECORDATION CERTIFICATE
Filing Requirement of Act 74, Mich. PA 1970

For Corners In: Gladwin Located In _____ Corner Code # _____
(County)


- | | | | |
|--------------------------------------|------------|--------------|-----------------------|
| 1. Public Land Survey | T _____ | R _____ | _____ |
| | T _____ | R _____ | _____ |
| 2. Property Controlling in Section | S <u>5</u> | T <u>19N</u> | R <u>2E</u> <u>9</u> |
| | S <u>5</u> | T <u>19N</u> | R <u>2E</u> <u>16</u> |
| 3. Miscellaneous Property in Section | S _____ | T _____ | R _____ |
| | S _____ | T _____ | R _____ |

4. Lot No: _____ Recorded Plat: _____
5. Private Claims: _____

I, Craig W. McVean, in a field survey on April 11, 2006 do hereby state that under requirements of PA 74, Michigan PA of 1970, the corner points mentioned in lines 1 and 2 above were in conformance with regulations and rules therefore as required in the current manual of survey instructions of the United States Department of the Interior, Bureau of Land Management or by a decree of a Court of Law and/or that the corner points mentioned in lines 3, 4 and 5 above were in conformance with the rules of the Michigan Board of Land Surveyors or by a Decree of a Court of Law; established, re-established, monumented, recovered, found as expressed below:

NOTE: Not more than 2 corners, all in the same town and range, may be recorded on this certificate.

Register of Deeds Stamp & File Number

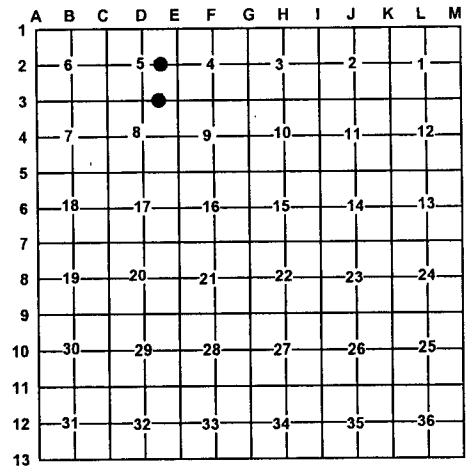

- A. Description of original monument and accessories and/or subsequent restoration:
- | | |
|---|---|
| <u>9</u> – Rec. Survey – L. 1, p. 394 – A. V. Courtright – 1974 – Set | <u>16</u> – Rec. Survey – L. 1, p. 394 – A. V. Courtright – 1974 – Set
- DNR Cor. Rec. – K. J. Ostling – 1971
Set 1 1/4" pipe – 2' long.
8" Cedar S82°W 98.8';
8" Cedar S53°E 57.3' |
|---|---|

- B. Description of corner evidence found and/or method applied in restoring or re-establishing corner:
- | | |
|---|--|
| <u>9</u> – CE 1/16 Cor. Sec. 5, T19N, R2E – Fd. Cap #4672 on 5/8" rebar 0.95' South of E-W 1/4 line per Courtright. Set 2" Alum. Cap on 5/8" x 34" rebar by extending E. line of Courtright Rec. Sur. North to intersect E-W 1/4 line. Set 2" Alum. Cap is 0.83' E. of midpoint between calculated 'D2' and Fd. 'E2'. 2" Alum. Cap accepted as the best available evidence of the position of the corner. | <u>16</u> – E 1/16 Corner common to Sec. 5 & 8, T19N, R2E – Set 2" Alum. Cap on 5/8" x 34" rebar by extending E. line of Courtright record survey – Fd. 5/8" CIR at 2638.2' North and Fd. 1/2" CIP 51' North – S. to intersect Sec. line. 2" Alum. Cap is 1.44' East of Midpoint between 'D3' and 'E3'. Centerline of E-W gravel rd. is 18' N. Fence wire to N. is 50'± E. 2" Alum. Cap accepted as the best available evidence of the position of the corner.

<u>Reference Pt.</u> – N10°15'W 18.4' of '16' found 1 1/4" iron pipe per Ostling in centerline of E-W gravel rd. Ostling pipe based on rejected 'D3' and 'C3' positions. 1 1/4" iron pipe not utilized as '16' in this survey. |
|---|--|

- C. Description of monument for corner and accessories established to perpetuate locating the position of the corner:
- | | |
|---|--|
| <u>9</u> – Stamped 2" Alum. Cap on 5/8" x 34" rebar. Set Blue Carsonite Post w/ Loc. tag 1' SE. South 0.95' to Fd. 5/8" rebar w/ Cap #4672 N67°E 8.49' to Set N & T in S. side 10" R. Maple N2°E 27.61' to set N & T in E. side 4" R. Maple West 34.75' to set N & T in S. side 22" R. Maple N29°E 40.99' to set N & T in SE side 6" R. Maple | <u>16</u> – Stamped 2" Alum. Cap on 5/8" x 34" rebar. Set Blue Carsonite Post w/ loc. tag 1' SE N86°W 100.72' to set N & T in S. side 16" Cedar – (KJO) S70°E 46.58' to set N & T in S. side 12" Cedar (KJO) S14°E 43.55' to set N & T in W. side Tw. 14" R. Maple North 50.99' to fd. Cap #4672 on 1/2" iron pipe on line. N88°W 3.79' to Fd. conc. Mon. N10°15'W 18.4' to Ref. Pt. – 1 1/4" pipe |
|---|--|

Signed by: Craig W. McVean
Surveyor's Michigan License No.: 39088

Date: 5/9/2007

