LAND CORNER RECORDATION CERTIFICATE

Filing Requirement of Act 74, Mich. P.A. 1970

For corners in GLADWIN (County)

	Located In:	Corner Code #
1. Public Land Survey	T 19N R 2E	E-13, F-13,
	T ____ R ____	G-13, H-13
	T ____ R ____	
	T ____ R ____	
2. Property Controlling	S ____ T ____ R ____	
in Section	S ____ T ____ R ____	
3. Miscellaneous	S ____ T ____ R ____	
Property in Section	S ____ T ____ R ____	

Register of Deeds Stamp & File Number

4. Lot No. _____, Recorded Plat _____
5. Private Claims _____

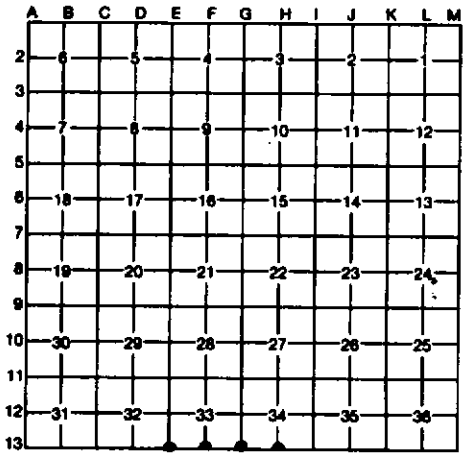

I, C.T. KIISKILA, in a field survey on JULY 18, 19 94, do hereby certify that under requirements of P.A. 74, Michigan P.A. of 1970, the corner points mentioned in lines 1 and 2 above were in conformance with regulations and rules therefore as required in the current manual of survey instructions of the United States Department of the Interior, Bureau of Land Management or by a decree of a Court of Law and/or that the corner points mentioned in lines 3, 4 and 5 above were in conformance with the rules of the Michigan Board of Professional Surveyors or by a Decree of a Court of Law; established, re-established, monumented, re-monumented, recovered, found as expressed below:

NOTE: Not more than 4 corners, all in the same town and range, may be recorded on this certificate.

A. Description of original monument and accessories and/or subsequent restoration:

E-13 F-13 G-13 H-13

(NO EVIDENCE OF G.L.O. CORNER, B.T'S, LINE TREES & TOPOGRAPHY, AS CALLED OUT IN THE G.L.O. LINE NOTES; UNLESS NOTED IN ITEM "B" BELOW.)

STATE OF MICHIGAN
CARL KIISKILA
LAND SURVEYOR
No. 33981
LICENSED LAND SURVEYOR

B. Description of corner evidence found and/or method applied in restoring or reestablishing corner:

E-13
RESET SE COR G-32 FROM 2 1985 J.PINE NOT STUMP REMAINS PER P.S. C.JOHNSON'S DEPT SURVEY. COR WAS DESTROYED DURING TIMBER HARVEST-CLEARCUT. C.JOHNSON HAS FOUND 1 1/4" PIPE BY H.SCHAAF (H.S. SET PIPE IN 1930'S FROM TWO U.S. BT STUMPS.) WINDING TRAIL N'LY & SE'LY IS 719'± E. WINDING N-S TRAIL IS 1326' N.

F-13
ACCEPTED 1 1/2" PIPE FOR S 1/4 COR S-33. COR PROBABLY SET BY H.SCHAAF, CONSERVATION DEPT FORESTER-SURVEYOR IN 1930'S ±.

G-13
REESTABLISHED SE COR S-33 AT RECORD US GLO DIST. (7.30') EAST OF FD NE COR S-4 (T18N-R2E) AND ON LINE ACROSS SAID NE COR S-4 & FD S 1/4 COR S-33 (T19N-R2E).

H-13
REESTABLISHED S 1/4 SEC 34 MIDWAY & ON LINE BETWEEN SE 34 & SW SEC 34. (7.3' E OF FD NW SEC 3 T18N-R2E). CORNER IN CENTER OF SAND RD LOOKING TO N & 7'± 3' S OF CTR SAND RD LOOKING TO E.

C. Description of monument for corner and accessories established to perpetuate locating the position of the corner:

E-13
SET DNR MON & CED POST.

DNR MON, NW COR SEC 4
T18N-R2E N89°56'W 8.00'
NO WITS AVAILABLE.

F-13
FD OLD 1 1/2" X 30" PIPE.
DROVE 1" X 84" GALV PIPE W/ALUM DNR CAP. SET CED POST.

12" ASH	N85°W	83.6'
6" MAPLE	N03°E	38.3'
8" MAPLE	N43°E	51.2'

N1/4 COR S-4 T18N-R2E DNR MON S89°59'W 7.54'

G-13
SET DNR MON & CED POST.

8" TW MAPLE	N40°W	19.0'
3" B CHERRY	S85°E	21.0'
7" MAPLE	S30°W	18.6'
3" B CHERRY	S70°W	17.5'

DNR MON, NW S-3
T18N-R2E N89°59'W 7.30

H-13
DROVE 5/8" X 34" REROD W/RLS CAP.

8" MAPL CLP3	N45°W	29.3'
14" MAPLE	N40°E	50.1'
2" MAPLE CLP	S25°E	33.5'
10" MAPLE	S85°W	19.8'

5/8" X 34" REROD N1/4 S-3
T18N-R2E S89°57'W 3.65'

Signed by Carl T. Kiiskila Date 3-28-97

Surveyor's Michigan License No. 33981

FORM APPROVED BY MICHIGAN STATE BOARD OF PROFESSIONAL SURVEYORS, JAN. 20, 1971
REVISED MAY 14, 1975
REVISED JAN., 1983