

LAND CORNER RECORDATION CERTIFICATE

FILING REQUIREMENT OF ACT 74, MICH. P.A.1970

FOR CORNERS OF--:	LOCATED IN--:	CORNER CODE NUMBER
1. PUBLIC LAND SURVEY	T. <u>19</u> N. R. <u>2</u> E.	<u>E-13;D-13;C-13;</u>
2. PROPERTY CONTROLLING IN SECTION	<u>32</u> , T. <u>19</u> N. R. <u>2</u> E.	<u>16</u>
3. MISCELLANEOUS PROPERTY IN SECTION	T. _____ N. R. _____ E.	_____
4. LOT NO. _____, RECORDED PLAT _____		
5. PRIVATE CLAIMS _____		

REGISTER OF DEEDS STAMP AND FILING NUMBER

I, Carl F. Roser, do hereby certify that under requirements of P.A. 74, Michigan P.A. of 1970, the corner points mentioned in lines 1 and 2 above were, in a field survey on October 22, 1984, established, re-established, monumented, re-monumented, recovered or restored as expressed below and in conformance with regulations and rules therefore as required in the current manual of survey instructions of the United States Department of the Interior, Bureau of Land Management or by a decree of a court of law. Furthermore, that the corner points mentioned in lines 3, 4 and 5 above were, in a field survey on _____, 19____, found, recovered, restored, established or re-established as expressed below and in conformance with the rules of the Michigan State Board of Registration for Land Surveyors or, by a

Decree of a Court of law:
C. Continued

	<u>D-13</u>		<u>C-13</u>	
Set DNR mon. & cedar post			Set DNR monument	
7" Aspen N45°E	15.4'		12" Red Oak N48°E	74.4'
5" Aspen N59°W	17.2'		7" Red maple S80°W	39.0'
			Cedar Post S85°E	4.0'

- B. Description of corner evidence found and/or method applied in restoring or re-establishing corner:
- E-13 - Set corner at found 1 1/2" pipe, apparently set by Schaaf, 1930's, from two U.S.BT. stumps. *(Standard Corner)*
 - 16 - Set corner by standard survey procedure for subdivision of sections.
 - D-13 - Set corner at found 1 1/2" pipe apparently set by Schaaf, 1930's. *(Std. Cor.)*
 - C-13 - Set corner at found 1 1/2" pipe, apparently set by Schaaf, 1930's, in N-S road. *Cor. Comm. to Sec's 31 & 32 (19-2) and Sec's 5 & 6 (18-2).*

C. Description of monument for corner and accessories established to perpetuate locating the position of the corner:

	<u>E-13</u>		<u>16</u>	
Set DNR monument & Cedar Post			Set 5/8" bar w/cap & cedar post	
8" Jackpine N86°E	18.2'		5" Cherry N39°E	21.3'
6" Jackpine N30°W	4.2'		12" White Oak S29°E	26.1'
<i>Fd. 1 1/4" Pipe West 8.0'</i>			<i>7d- 1 1/2" Pipe N42°W</i>	4.1'
<i>(Closing Cor.)</i>				


SIGNED BY Carl F. Roser 03-13-85 DATE

SURVEYOR'S MICHIGAN REGISTRATION NO. 12028

FOR STATE AND UNITED STATES AGENCIES:

SIGNED BY _____ DATE _____
CHIEF OF SURVEY PARTY

APPROVED AND SIGNED BY _____ DATE _____
MICHIGAN REGISTERED LAND SURVEYOR

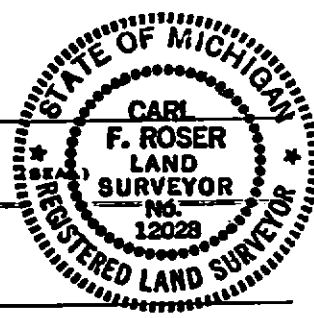

SURVEYOR'S MICHIGAN REGISTRATION NO. _____ GLADWIN COUNTY