

STATE OF MICHIGAN
DEPARTMENT
OF
NATURAL RESOURCES

LAND CORNER RECORD

GLADWIN COUNTY


T 19 N R 2 E

DESCRIPTION OF CORNER Sec. corner common to Sections 17-18-19-20

CORNER MONUMENT Set Dept. Monument

DATE MONUMENT PLACED AND WITNESSED 5-3-71

WITNESSES TO CORNER.....

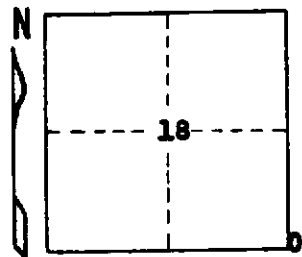

Chiseled ϕ in Ctr.
of Steel Bridge
Rail

S 70 E 30.35'

Ditto

N 74 E 30.75'

AND

Ctr. of U.S.G.S. Mon. N 42 W 35.8'

CIRCLE CORNER REGISTERED

DESCRIPTION IN DETAIL AS TO HOW CORNER WAS LOCATED AND IDENTIFIED OR RESTORED.

This corner was found by stake point and square head bolt. Oct. 1970.
Replaced with Dept. Monument.

SURVEYOR'S SEAL

SIGNED

Conrad J. Ostling

DATE

5-10-71

DISTRIBUTION:

REGISTERED LAND SURVEYOR 10068

County Courthouse
Area Forester (Regions I & II)
District or Region Surveyor
Forestry Div., Lansing

R 4047
Rev. 10/68