

STATE OF MICHIGAN
DEPARTMENT
OF
NATURAL RESOURCES

LAND CORNER RECORD

GLADWIN COUNTY


T 19 N R 2 E

DESCRIPTION OF CORNER Sec. corner common to Sections 5-6-7-8

CORNER MONUMENT Set Dept. Monument

DATE MONUMENT PLACED AND WITNESSED 4-29-71

WITNESSES TO CORNER.....

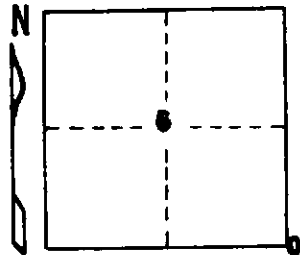

CIRCLE CORNER REGISTERED

24" W.P. Stp. S 30 W 56.1'

36" W.P. Stp. N 73 E 101.2'

AND
Corner Fence P. WEST 27.1'

DESCRIPTION IN DETAIL AS TO HOW CORNER WAS LOCATED AND IDENTIFIED OR RESTORED.

This corner was found in approximate center of road intersection October 1970. Found 1/2" rerod which Mr. Laverne Boman says he placed in the location of an old wood stake point which he found. This point recorded as a stake at road intersection in record of C.C.C. Survey, about 1935.

SURVEYOR'S SEAL

SIGNED *Timothy Ostling* DATE 5-13-71
REGISTERED LAND SURVEYOR 10068

DISTRIBUTION:

County Courthouse
Area Forester (Regions I & II)
District or Region Surveyor
Forestry Div., Lansing

R 4047
Rev. 10/68