

SURVEY & MONUMENTATION

JAN 17 1996

COMMISSION

LAND CORNER RECORDATION CERTIFICATE
Filing Requirement of Act 74, Mich. P.A. 1970

LIBER 001 PAGE 91

For corners in

<u>GLADWIN</u> (County)	Located In:	Corner Code #
1. Public Land Survey	T19N R.2W	1-8
	T R	
	T R	
	T R	
2. Property Controlling in Section	S T R	
	S T R	
3. Miscellaneous Property in Sec.	S T R	
	S T R	
4. Lot No. _____, Recorded Plat _____		
5. Private Claims _____		

STATE OF MICHIGAN
GLADWIN COUNTY
FILED-REMONUMENTATION

26 DEC 95 10:54 A.M.

BONNIE K. HOUSE
REGISTER OF DEEDS

Register of Deeds Stamp & File Number

I, PAUL B. LAPHAM, in a field survey on MAY-NOVEMBER, 1995 do hereby state that under requirements of P.A. 74, Michigan P.A. of 1970, the corner points mentioned in lines 1 and 2 above were in conformance with regulations and rules therefore as required in the current manual of survey instructions of the United States Department of the Interior, Bureau of Land Management or by a decree of a Court of Law and/or that the corner points mentioned in lines 3, 4 and 5 above were in conformance with the rules of the Michigan Board of Land Surveyors or by a Decree of a Court of Law, established, re-established, monumented, recovered, found as expressed below:

NOTE: Not more than 2 corners, all in the same town and range, may be recorded on this certificate.

A	B	C	D	E	F	G	H	I	J	K	L	M
1												
2	6	5	4	3	2	1						
3												
4	7	8	9	10	11	12						
5												
6	18	17	16	15	14	13						
7												
8	19	20	21	22	23	24						
9												
10	30	29	28	27	26	25						
11												
12	31	32	33	34	35	36						
13												

A. Description of original monument and accessories and/or subsequent restoration:

1856 LEVI H. CANNON
OLD 1/4 CORNER, LEFT NO. POST
WIT.-(1)HEMLOCK 20" EAST 2
(2)BEECH 12" N51°W 50

1973 LAPHAM SURVEY
FOUND 2"x1/4" STRAP IRON
WIT.-(6)N45°E 59.90' COR. POST
(7)S40°E 51.42' TELE. POLE
(8)N60°W 40.50' POWER POLE

1991 LAPHAM UNRECORDED L.C.R.C. FOR
COUNTY ROAD CONSTRUCTION
FOUND 1/4"x2" STRAP IRON
WIT.-(9)S48°E TELE. 51.40'
(10)N60°W POWER POLE 40.50'
(11)S60°E M.B.T. RISER TOP CENTER 73.00'
(12)S80°E 4" ASH 89.54'

1910 GLADWIN COUNTY SURVEY RECORD-DWG
NO WITNESSES


1973 LAPHAM L.C.R.C. #74
FOUND 1/4"x2" STRAP IRON
WIT.-SAME AS (6), (7) & (8) ABOVE

1992 LAPHAM
SET C.I.

1968 LAPHAM
WITNESS CARD, FOUND 2" STRAP IRON
WIT.-(3)N60°W POWER POLE 40.5'
(4)S45°E TELE. POST 50.80'
(5)N45°E CORNER POST 39.90'

B. Description of corner evidence found and/or method applied in restoring or reestablishing corner:

FOUND CAPPED IRON, INTERSECTION OF COUNTY ROAD REMOVED SET GLADWIN REMON IN PLACE OF FOUND
IRON MATCHES WITNESSES (3), (7), (9), (10) & (12)

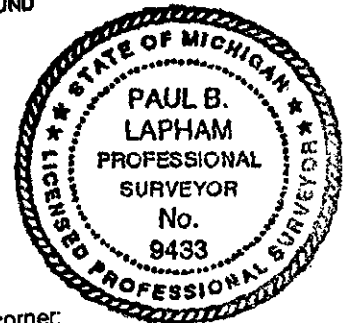

This Corner established in Gladwin County Remonumentation Program.

See dossier for detailed report.

C. Description of monument for corner and accessories established to perpetuate locating the position of the corner:

1-8: CORNER COMMON TO SECTIONS 22 & 23
SET 5/8"x36" RE-ROD WITH GLADWIN COUNTY REMON CAP MARKED 9433 IN MONUMENT BOX.

WITNESSES:
S48°E 51.40' - NAIL & TAG IN TELE. POLE
N60°E 40.52' - NAIL & TAG IN POWER POLE
S80°E 89.54' - NAIL & TAG IN 8" ASH
N45°E 52.40' - 1/2"x36" RE-ROD (BELOW SURFACE)
NORTH P.K. NAIL 2.0
EAST P.K. NAIL 2.0

APPROVED LAND CORNER
P.A. 345 of 1990
Gladwin County

Co. Rep. [Signature]
Date 12/18/95

Signed by Paul B. Lapham
Surveyor's Michigan License No. 9433

Date 12-22-95