

**SURVEY &
REMONUMENTATION**

JAN 17 1996

LAND CORNER RECORDATION CERTIFICATE
Filing Requirement of Act 74, Mich. P.A. 1970

LIBER **001** PAGE **94**

For corners in **COMMISSION**

<u>GLADWIN</u> (County)	Located In:	Corner Code #
1. Public Land Survey	T <u>19NR 2W</u>	<u>1-11</u>
	T <u> R </u>	<u> </u>
	T <u> R </u>	<u> </u>
	T <u> R </u>	<u> </u>
2. Property Controlling in Section	S <u> T </u>	<u> </u>
	S <u> T </u>	<u> </u>
3. Miscellaneous Property in Sec.	S <u> T </u>	<u> </u>
	S <u> T </u>	<u> </u>

STATE OF MICHIGAN
GLADWIN COUNTY
FILED-REMONUMENTATION

26 DEC 95 10:55 A.M.

BONNIE K. HOUSE
REGISTER OF DEEDS

Register of Deeds Stamp & File Number

4. Lot No. _____, Recorded Plat _____
5. Private Claims _____

I, PAUL B. LAPHAM, in a field survey on MAY--
NOVEMBER, 1995 do hereby state that under requirements of P.A. 74, Michigan P.A. of 1970, the corner points mentioned in lines 1 and 2 above were in conformance with regulations and rules therefore as required in the current manual of survey instructions of the United States Department of the Interior, Bureau of Land Management or by a decree of a Court of Law and/or that the corner points mentioned in lines 3, 4 and 5 above were in conformance with the rules of the Michigan Board of Land Surveyors or by a Decree of a Court of Law; established, re-established, monumented, recovered, found as expressed below:

NOTE: Not more than 2 corners, all in the same town and range, may be recorded on this certificate.

A	B	C	D	E	F	G	H	I	J	K	L	M
1												
2	6	5	4	3	2	1						
3												
4	7	8	9	10	11	12						
5												
6	18	17	16	15	14	13						
7												
8	19	20	21	22	23	24						
9												
10	30	29	28	27	26	25						
11												
12	31	32	33	34	35	36						
13												

A. Description of original monument and accessories and/or subsequent restoration:

1856 LEVI H. CANNON
SET POST FOR 1/4 CORNER
WIT.-(1) BUTTERNUT 16" S50°W 45'
(2) CEDAR 15" N52°E 16'

1950 EDMAND & DUNDAS
WORKING DWG & WITNESSES
WIT.-(3) EAST 22.2' P.P.
(4) N.W. TELE. POLE 46.65'

1963 LAPHAM WITNESS CARD
FOUND CABIN SPIKE
WIT.-(5) N.W. 24" ELM 70.5'
(6) EAST P.P. 31.9'


1966 CALDWELL
WITNESSES SHEET
FOUND 14" SPIKE IN CENTERLINE ROAD
WIT.-(7) N85°E 32.0' P.P.
(8) S50°E 44.15' 4TH FENCE POST
(9) N45°W 65.4' 16" ELM
(10) WEST 39.6' FENCE COR. POST

1976 LAPHAM SURVEY
SET R.R. SPIKE
WIT.-(11) WEST P.P. 33.00'
(12) EAST 37.85' P.P.
(13) S30°E 55.90' FENCE POST

1977 LAPHAM L.C.R.C. #77
WIT.-SAME AS (11), (12), & (13)
1978 LAPHAM SURVEY #782000
WIT.-SAME AS (11), (12) & (13)
1982 LAPHAM SURVEY #824149
WIT.-SAME AS (11), (12) & (13)
1987 LAPHAM SURVEY #G-877395
WIT.-SAME AS (11), (12) & (13)
1991 LAPHAM SURVEY #G-911398
WIT.-SAME AS (11), (12) & (13)
1993 LAPHAM SURVEY #G-933585
WIT.-SAME AS (11), (12) & (13)

B. Description of corner evidence found and/or method applied in restoring or reestablishing corner:

FOUND R.R. SPIKE 4' WEST CENTER LINE, FENCE EAST & WEST, EXCAVATED FOUND NO OTHER CORNER,
FOUND (13) LEANING, SET UP RIGHT MEAS. 56.0± REC. 55.90'
FOUND (10) MEAS. 32.77' TO FACE, REC. 33.00', MAYBE NEW POLE
FOUND (12) MEAS. 37.80' TO FACE, REC. 37.85' SET GLADWIN REMON IN PLACE OF FOUND CORNER

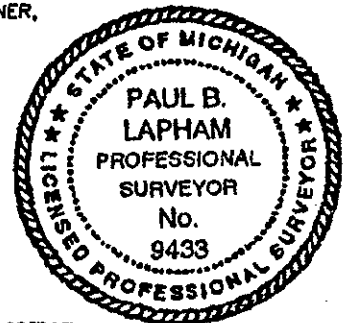

This Corner established in Gladwin County Remonumentation Program.

See dossier for detailed report.

C. Description of monument for corner and accessories established to perpetuate locating the position of the corner:

1-11: CORNER COMMON TO SECTIONS 26, 27, 34 & 35
SET 5/8" x 36" RE-ROD WITH GLADWIN COUNTY RE-MON CAP, MARKED P.S. #9433.

WITNESSES:
WEST 33.17' - NAIL & TAG IN POWER POLE
EAST 38.24' - NAIL & TAG IN POWER POLE
S45°W 76.12' - NAIL & TAG IN 3" SPRUCE
N45°E 66.51' - NAIL & TAG IN 8" S. PINE
NORTH P.K. NAIL 2.0'
EAST P.K. NAIL 2.0'

APPROVED LAND CORNER
P.A. 345 of 1990
Gladwin County

Co. Rep. [Signature]
Date 12/18/95

Signed by Paul B. Lapham
Surveyor's Michigan License No. 9433

Date 12-22-95