

**SURVEY &
REMONUMENTATION**

JAN 17 1996

COMMISSION LAND CORNER RECORDATION CERTIFICATE
Filing Requirement of Act 74, Mich. P.A. 1970

For corners in

<u>GLADWIN</u> (County)	Located In:	Corner Code #
1. Public Land Survey	T <u>19N</u> R <u>2W</u>	<u>K-12</u>
	T <u> </u> R <u> </u>	<u> </u>
	T <u> </u> R <u> </u>	<u> </u>
	T <u> </u> R <u> </u>	<u> </u>
2. Property Controlling in Section	S <u> </u> T <u> </u> R <u> </u>	<u> </u>
	S <u> </u> T <u> </u> R <u> </u>	<u> </u>
3. Miscellaneous Property in Sec.	S <u> </u> T <u> </u> R <u> </u>	<u> </u>
	S <u> </u> T <u> </u> R <u> </u>	<u> </u>
4. Lot No. _____, Recorded Plat _____		
5. Private Claims _____		

LIBER **001** PAGE **88**

STATE OF MICHIGAN
GLADWIN COUNTY
FILED-REMONUMENTATION

26 DEC 95 10:54 A.M.

Register of Deeds Stamp & File Number
BONNIE K. HOUSE
REGISTER OF DEEDS

1	A	B	C	D	E	F	G	H	I	J	K	L	M
2	6		5		4		3		2		1		
3													
4	7		8		9		10		11		12		
5													
6	18		17		16		15		14		13		
7													
8	19		20		21		22		23		24		
9													
10	30		29		28		27		26		25		
11													
12	31		32		33		34		35		36		
13													

I, PAUL B. LAPHAM, in a field survey on MAY-NOVEMBER, 19 95 do hereby state that under requirements of P.A. 74, Michigan P.A. of 1970, the corner points mentioned in lines 1 and 2 above were in conformance with regulations and rules therefore as required in the current manual of survey instructions of the United States Department of the Interior, Bureau of Land Management or by a decree of a Court of Law and/or that the corner points mentioned in lines 3, 4 and 5 above were in conformance with the rules of the Michigan Board of Land Surveyors or by a Decree of a Court of Law; established, re-established, monumented, recovered, found as expressed below:

NOTE: Not more than 2 corners, all in the same town and range, may be recorded on this certificate.

A. Description of original monument and accessories and/or subsequent restoration:

1856 LEVI H. CANNON
WIT.-(1)POST HEMLOCK 26 S61°E 12
(2)DO 11 S44°W 13

1960 PAUL LAPHAM SURVEY
NO WITNESSES

1973 PAUL LAPHAM L.C.R.C. #74
FOUND 1/2" BAR
WIT.-(3)WEST 79.64' WILD CHERRY
(4)N45°E 77.33' POWER POLE
(5)S35°W 69.72' POWER POLE

1973 PAUL LAPHAM SURVEY
SAME AS NO. (3), (4) & (5)

1979 PAUL LAPHAM SURVEY
SAME AS NO. (3), (4) & (5)

1981 PAUL LAPHAM SURVEY
SAME AS NO. (3), (4) & (5)

1991 PAUL LAPHAM
UNRECORDED WITNESSES FOR COUNTY
ROAD CONSTRUCTION
FOUND 1/2" IRON
WIT.-(6)N40°E POWER POLE 72.50'
(7)WEST CHERRY TREE 79.70'
(8)S45°W POWER POLE 85.0'
(9)N45°E POWER POLE 78.95'

LAPHAM WORK SHEET (3)

B. Description of corner evidence found and/or method applied in restoring or reestablishing corner:

FOUND 1/2" IRON IN HOLE IN ASPHALT NO OTHER CORNER FOUND. MATCH WITNESSES NO. (3), (6), (7) & (8).
SET GLADWIN MON FROM FOUND IRON AND WITNESSES (3), (6), (7) & (8)


This Corner established in Gladwin County Remonumentation Program.

See dossier for detailed report.

C. Description of monument for corner and accessories established to perpetuate locating the position of the corner:

K-12: CORNER COMMON TO 35 & 36
SET 5/8"x36" RE-ROD WITH GLADWIN COUNTY RE-MON CAP, MARKED P.S. #9433.

WITNESSES:
N40°E 72.55' - NAIL & TAG IN POWER POLE
WEST 79.67' - NAIL & TAG IN CHERRY TREE
S45°W 84.89' - NAIL & TAG IN POWER POLE
S35°W 78.86' - NAIL & TAG IN POWER POLE
NORTH P.K. NAIL 2.0'
EAST P.K. NAIL 2.0'

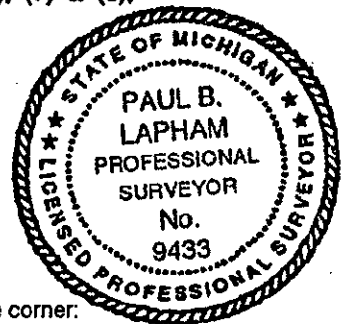

APPROVED LAND CORNER
P.A. 345 of 1990
Gladwin County

Co. Rep. [Signature]
Date 12/14/95

Signed by [Signature]
Surveyor's Michigan License No. 9433

Date 12-22-95