

SURVEY & REMONUMENTATION

DEC 16 1996

COMMISSION

GLADWIN COUNTY REMONUMENTATION

LAND CORNER RECORDATION CERTIFICATE
Filing Requirement of Act 74, Mich. P.A. 1970

LIBER **001** PAGE **106**

For corners in
GLADWIN
(County)

Located In:	Corner Code #
T 19N R 2W	M - 11
T R	
T R	
T R	
T R	
S T R	
S T R	
S T R	
S T R	

- 1. Public Land Survey
- 2. Property Controlling in Section
- 3. Miscellaneous Property in Sec.

4. Lot No. _____, Recorded Plat _____
5. Private Claims _____

STATE OF MICHIGAN
GLADWIN COUNTY
FILED-REMONUMENTATION

2 DEC 96 3:23 P.M.

RONNIE K. HOUSE
REGISTER OF DEEDS

Register of Deeds Stamp & File Number

	A	B	C	D	E	F	G	H	I	J	K	L	M
1													
2	6		5		4		3		2		1		
3													
4	7		8		9		10		11		12		
5													
6	18		17		16		15		14		13		
7													
8	19		20		21		22		23		24		
9													
10	30		29		28		27		26		25		
11													
12	31		32		33		34		35		36		
13													

I, MARK ROBISON, in a field survey on November, 1996 do hereby state that under requirements of P.A. 74, Michigan P.A. of 1970, the corner points mentioned in lines 1 and 2 above were in conformance with regulations and rules therefore as required in the current manual of survey instructions of the United States Department of the Interior, Bureau of Land Management or by a decree of a Court of Law and /or that the corner points mentioned in lines 3, 4 and 5 above were in conformance with the rules of the Michigan Board of Land Surveyors or by a Decree of a Court of Law; established, re-established, monumented, recovered, found as expressed below:

NOTE: Not more than 2 corners, all in the same town and range, may be recorded on this certificate.

- A. Description of original monument and accessories and/or subsequent restoration:
- 1877 T. GALE MERRILL
SET POST
WIT.-(1)B. ASH 8 S38W 10 1/2
(2)B. ASH N35W 32 1/2
 - 1965 PAUL LAPHAM-DWG. & FIELD NOTES
WIT.-NONE
SET CORNER OVER REACTION
 - 1981 PAUL LAPHAM SURVEY
WIT.-NONE
 - 1980 PAUL LAPHAM
AGREES WITH WRIGHT SUBD N-S DISTANCE
 - 1990 PAUL LAPHAM SURVEY
FOUND MONUMENT BOX
WIT.-(3)EAST 1.0 C/L M-18
(4)N65E 59.50 P.P.
(5)S45E 51.85 TOP CEN 18" CMP
(6)S35W 36.35 SW COR HEADWALL

APPROVED LAND CORNER
P.A. 245 of 1990
Gladwin County

Ch. Rep. [Signature]
Date 11/6/96

B. Description of corner evidence found and/or method applied in restoring or reestablishing corner:


FOUND 5/8" ROD IN MON BOX 1' WEST OF C/L HWY M-18. FOUND WITNESS (4); REC. 59.5, MEAS. 59.6. FOUND (6); REC. & MEAS. 36.35. SET GLADWIN RE-MON CAP ON FOUND 5/8" ROD IN MON BOX.

SEE DOSSIER FOR DETAILED REPORT.

C. Description of monument for corner and accessories established to perpetuate locating the position of the corner:

M-11: SE CORNER OF SECTION 25
PLACED GLADWIN RE-MON CAP MARKED P.S.#27458 OVER FOUND 5/8" ROD IN MON BOX.

WITNESSES:
S35W SW COR HEADWALL 36.35' EAST, P.K. NAIL, 2.0'
N40W 14" ELM. N&T, 82.27'
N65E POWER POLE, N&T, 59.60'
S30E POWER POLE, N&T, 51.25'
NORTH, P.K. NAIL, 2.0'

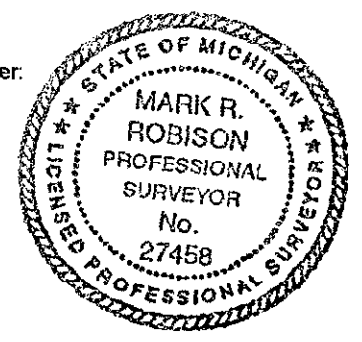

Signed by Mark R. Robison
Surveyor's Michigan License No. 27458

Date 11-29-96