

SURVEY & REMONUMENTATION

DEC 1 6 1996

GLADWIN COUNTY REMONUMENTATION

COMMISSION

LAND CORNER RECORDATION CERTIFICATE
Filing Requirement of Act 74, Mich. P.A. 1970

LIBER 001 PAGE 119

For corners in

<u>GLADWIN</u> (County)	Located In:	Corner Code #	
1. Public Land Survey	T 20N R 1E	F - 5	
	T R		
	T R		
	T R		
2. Property Controlling in Section	S T R		
	S T R		
3. Miscellaneous Property in Sec.	S T R		
	S T R		
4. Lot No. _____, Recorded Plat _____			
5. Private Claims _____			

STATE OF MICHIGAN
GLADWIN COUNTY
FILED-REMONUMENTATION

2 DEC 96 3:27 P.M.

RONNIE K. HOUSE
REGISTER OF DEEDS

Register of Deeds Stamp & File Number

I, MARK ROBISON, in a field survey on November, 1996, do hereby state that under requirements of P.A. 74, Michigan P.A. of 1970, the corner points mentioned in lines 1 and 2 above were in conformance with regulations and rules therefore as required in the current manual of survey instructions of the United States Department of the Interior, Bureau of Land Management or by a decree of a Court of Law and/or that the corner points mentioned in lines 3, 4 and 5 above were in conformance with the rules of the Michigan Board of Land Surveyors or by a Decree of a Court of Law; established, re-established, monumented, recovered, found as expressed below:

NOTE: Not more than 2 corners, all in the same town and range, may be recorded on this certificate.

A	B	C	D	E	F	G	H	I	J	K	L	M
1												
2	6	5	4	3	2	1						
3												
4	7	8	9	10	11	12						
5												
6	18	17	16	15	14	13						
7												
8	19	20	21	22	23	24						
9												
10	30	29	28	27	26	25						
11												
12	31	32	33	34	35	36						
13												

A. Description of original monument and accessories and/or subsequent restoration:

1846 JOHN MULLETT
SET 1/4 POST
WIT.-(1)HEMLOCK 10 S62E 25
(2)W. OAK 6 N45W 34

(4)N35E 111.84 POWER POLE
(5)N40W 76.05 12" WILD CHERRY

WIT.-SAME AS (3),(4)&(5)

1985 PAUL LAPHAM SURVEY
WIT.-SAME AS (3),(4)&(5)

UNKNOWN-WORKING DRAWING
WIT.-NONE

1970 PAUL LAPHAM-WORKING DRAWING
SECTION SUBDIVISION

1973 PAUL LAPHAM SURVEY
WIT.-SAME AS (3),(4)&(5)

1976 PAUL LAPHAM-WORKING DRAWING
SECTION SUBDIVISION
WIT.-NONE

1973 PAUL LAPHAM L.C.R.C.#75
FOUND 1/2" BAR
WIT.-(3)S20W 62.96 6" OAK TREE

1982 PAUL LAPHAM SURVEY

B. Description of corner evidence found and/or method applied in restoring or reestablishing corner.

FOUND 2" X 2" IRON PIN IN C/L OF ROAD E&W, T-ROAD NORTH, 6" BELOW SURFACE; OLD WITH LARGE RUST BALL. FOUND (3)--NAIL IN 8" OAK, S20W; MEAS. 63.25, REC. 62.96. SET GLADWIN RE-MON IN LOCATION OF FOUND CORNER.

APPROVED LAND CORNER
P.A. 605 of 1990
Gladwin County


Co. Rep. [Signature]
Date 11/6/96

SEE DOSSIER FOR DETAILED REPORT.

C. Description of monument for corner and accessories established to perpetuate locating the position of the corner:

F-5: 1/4 CORNER COMMON TO SECTIONS 9 & 16
SET 5/8" X 36" REROD WITH GLADWIN CO. RE-MON CAP MARKED P.S.#27458

WITNESSES:
S20W 8" OAK, NAIL, 63.25'
N40E POWER POLE, N&T, 111.90'
S40E 3" OAK, N&T, 53.00'
S70W 18" PINE, N&T, 155.05'

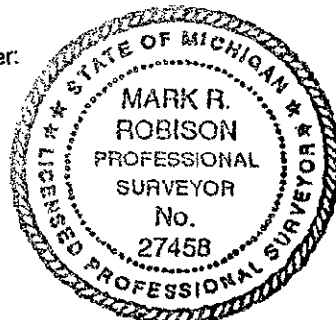

Signed by Mark R. Robison
Surveyor's Michigan License No. 27458

Date 11-29-96