

**SURVEY &
REMONUMENTATION**

DEC 16 1996

COMMISSION

GLADWIN COUNTY REMONUMENTATION

LAND CORNER RECORDATION CERTIFICATE
Filing Requirement of Act 74, Mich. P.A. 1970

LIBER **001** PAGE **121**

For corners in

<u>GLADWIN</u> (County)	Located In:	Corner Code #	
1. Public Land Survey	T 20N R 1E	G - 4	
	T R		
	T R		
	T R		
2. Property Controlling in Section	S T R		
	S T R		
3. Miscellaneous Property in Sec.	S T R		
	S T R		

STATE OF MICHIGAN
GLADWIN COUNTY
FILED-REMONUMENTATION

2 DEC 96 3:27 P.M.

BONNIE K. HOUSE
REGISTER OF DEEDS

Register of Deeds Stamp & File Number

4. Lot No. _____, Recorded Plat _____
5. Private Claims _____

I, MARK ROBISON, in a field survey on November, 1996 do hereby state that under requirements of P.A. 74, Michigan P.A. of 1970, the corner points mentioned in lines 1 and 2 above were in conformance with regulations and rules therefore as required in the current manual of survey instructions of the United States Department of the Interior, Bureau of Land Management or by a decree of a Court of Law and/or that the corner points mentioned in lines 3, 4 and 5 above were in conformance with the rules of the Michigan Board of Land Surveyors or by a Decree of a Court of Law; established, re-established, monumented, recovered, found as expressed below:

NOTE: Not more than 2 corners, all in the same town and range, may be recorded on this certificate.

	A	B	C	D	E	F	G	H	I	J	K	L	M
1													
2	6	5											
3													
4	7	8	9	10	11	12							
5													
6	18	17	16	15	14	13							
7													
8	19	20	21	22	23	24							
9													
10	30	29	28	27	26	25							
11													
12	31	32	33	34	35	36							
13													

A. Description of original monument and accessories and/or subsequent restoration:

- 1846 JOHN MULLETT SET 1/4 POST
WIT.-(1)CEDAR 10 N80W 36
(2)W. PINE 14 S48E 29
- 1957 COURTRIGHT-PLAT RAYMOND SUBD
- 1958 COURTRIGHT-PLAT INDIAN LAKE SUBD
- 1949-1959 M.S.H.D. 3/4" PIPE & MISC METAL
- WIT.-(3)N85W 28" OAK 75.31
(4)N50E 31" OAK 98.85
(5)S85E 15" OAK 30.36
(6)S40E 26" OAK 95.91
(7)S25E 15" OAK 81.36
- 1963 HENNING-SEC SUBD. FD CONC. MON.
WIT.-(8)CONC. MON 33 WEST
- 1973 P LAPHAM L.C.R.C. #75 FD 1/2" PIPE
WIT.-(9)S88E 30.24 15" TWIN OAKS
(10)N30E 54.02 6" WILLOW
(11)S60W 60.52 P.P.
- 1973 P LAPHAM UNREC LCRC-FD 3/8" REROD
WIT.-(12)EAST 36.19 T.P.
(13)S65W 60.48 UTIL. POLE
(14)WEST 33.0 CONC. MON.
- 1973 P LAPHAM SVY WIT.-SAME AS (9),(10)&(11)

- 1973 P LAPHAM SVY WIT.-SAME AS (9),(10)&(11)
- 1973+/- P LAPHAM SVY WORKING DWG & SEC SUBD
- 1975 CAVANAGH SVY FD PIPE WIT-NONE
- 1981 P LAPHAM SVY WIT.-SAME AS (9),(10)&(11)
- 1992 P LAPHAM SVY WIT.-SAME AS (9),(10)&(11)
- 1994 P LAPHAM SVY WIT.-SAME AS (9),(10)&(11)
- 1995 P LAPHAM SVY WIT.-SAME AS (9),(10)&(11)

B. Description of corner evidence found and/or method applied in restoring or reestablishing corner:

FOUND 3/4" PIPE & MISC IRON SCRAP IN C/L ROAD OPPOSITE FENCE TO EAST. FOUND (9) & (5)-BENT NAIL; MEAS. 30.30, REC. 30.36 & 30.24. FOUND (8)-CONC MON; REC. & MEAS. 33.00. FOUND (14) & (11)-N&T; MEAS. 60.55, REC.60.52. FOUND (12)-N&T; MEAS. 36.22, REC.36.19. FOUND (4)-48" OAK OLD BLAZE; MEAS. 98.5, REC. 98.65. FOUND (7)-30" OAK; MEAS. 81.05, CENTER OF TREE, REC.81.36. SET GLADWIN RE-MON FROM FOUND CORNER & WITNESSES.

SEE DOSSIER FOR DETAILED REPORT.


APPROVED LAND CORNER
P.A. 9.15 of 1990
Gladwin County

Co. Rep. Mark Robison
Date 11/29/96

C. Description of monument for corner and accessories established to perpetuate locating the position of the corner:

G-4: 1/4 CORNER COMMON TO SECTIONS 9 & 10
SET 5/8" X 3/8" REROD WITH GLADWIN RE-MON CAP MARKED P.S.#27458

- WITNESSES:
WEST CONC. MONUMENT 33.00'
S25E 30" OAK, N&T, 81.05'
S85W 30" OAK, N&T, 79.65'
S60W POWER POLE, N&T, 60.52'
EAST TELE. POLE, SPIKE, 36.20'

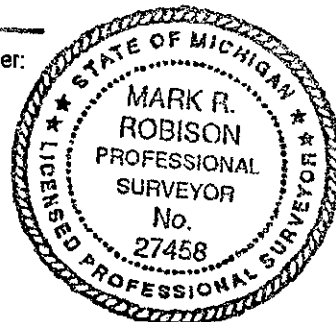

Signed by Mark R. Robison
Surveyor's Michigan License No. 27458

Date 11-29-96