

GLADWIN COUNTY REMONUMENTATION

LAND CORNER RECORDATION CERTIFICATE  
 Filing Requirement of Act 74, Mich. P.A. 1970

LIBER 001 PAGE 122

STATE OF MICHIGAN  
 GLADWIN COUNTY  
 FILED-REMONUMENTATION

2 DEC 96 3:28 P.M.

BONNIE K. HOUSE  
 REGISTER OF DEEDS

Register of Deeds Stamp & File Number

For corners in

GLADWIN (County)	Located In:	Corner Code #
1. Public Land Survey	T 20N R 1E	G - 5
	T R	
	T R	
	T R	
2. Property Controlling in Section	S T R	
	S T R	
3. Miscellaneous Property in Sec.	S T R	
	S T R	

4. Lot No. \_\_\_\_\_, Recorded Plat \_\_\_\_\_  
 5. Private Claims \_\_\_\_\_

I, MARK ROBISON, in a field survey on November, 1996 do hereby state that under requirements of P.A. 74, Michigan P.A. of 1970, the corner points mentioned in lines 1 and 2 above were in conformance with regulations and rules therefore as required in the current manual of survey instructions of the United States Department of the Interior, Bureau of Land Management or by a decree of a Court of Law and/or that the corner points mentioned in lines 3, 4 and 5 above were in conformance with the rules of the Michigan Board of Land Surveyors or by a Decree of a Court of Law, established, re-established, monumented, recovered, found as expressed below:

NOTE: Not more than 2 corners, all in the same town and range, may be recorded on this certificate.

	A	B	C	D	E	F	G	H	I	J	K	L	M
1													
2		6		5		4		3		2		1	
3													
4		7		8		9		10		11		12	
5													
6		18		17		16		15		14		13	
7													
8		19		20		21		22		23		24	
9													
10		30		29		28		27		26		25	
11													
12		31		32		33		34		35		36	
13													

A. Description of original monument and accessories and/or subsequent restoration:

- 1846 JOHN MULLETT SET COR. POST  
 WIT.-(1)CEDAR 8 S37W 18  
 (2)B. ASH 10 N35E 22
- 1940+- SPICER ENG. SURVEY  
 SET 4 X 4 WOOD POST
- 1950+- DUNDAS & EDMANDS ENG.  
 WIT.-(3)10" ELM N15E 101.92  
 (4)9" WILLOW N80E 68.59  
 (5)P.P. S05E 41.45
- 1949-1959 M.S.H.D. 3/4" PIPE FOUND  
 WIT.-SAME AS (3),(4)&(5)
- (6)S85W 15" OAK 142.92
- 1963 HENNING SET 1" X 36" PIPE  
 ELM 10" N20E 104.3
- 1965 EDMANDS ENG. WIT.-NONE
- 1972 PAUL LAPHAM SURVEY FD 1" PIPE  
 WIT.-(7)SOUTH 41.55 P.P.  
 (8)N45W 127.90 10" OAK
- 1973+- PAUL LAPHAM-WORKING DRAWING  
 SECTION SUBDIVISION DRAWINGS
- 1991 LEDY SURVEY FOUND 1" PIPE  
 WIT.-(9)NNE 62.60 SPIKE IN 12" WILLOW
- (10)S41.50 N&D (MDOT) IN P.P  
 (11)S80W 143.29 SPIKE 18" OAK  
 (12)NW 8.2 C/L ELY LEG SIGN
- 1994 PAUL LAPHAM SURVEY  
 WIT.-SAME AS (7)&(8)  
 (13)N06W 41.75 CAPPED IRON
- 1995 PAUL LAPHAM SURVEY  
 WIT.-SAME AS (7),(8)&(13)

B. Description of corner evidence found and/or method applied in restoring or reestablishing corner:

FOUND 1" X 36" PIPE 50'+- SE OF C/L COUNTY ROAD, P.I. FOR COUNTY ROAD NORTH & WEST. FOUND (5),(7)&(10), N&T; MEAS. 41.55, REC. 41.45, 41.55 & 41.50. FOUND (11); REC. & MEAS. 143.29. FOUND (9); REC. & MEAS. 62.60. SET GLADWIN RE-MON FROM FOUND CORNER & WITNESSES

APPROVED LAND CORNER  
 P.A. 745 of 1980  
 Gladwin County


SEE DOSSIER FOR DETAILED REPORT.

Co. Rep. Mark R. Robison  
 Date 11/6/96

C. Description of monument for corner and accessories established to perpetuate locating the position of the corner:

G-5: CORNER COMMON TO SECTIONS 9, 10, 15 & 16  
 SET 5/8" X 36" REROD WITH GLADWIN COUNTY RE-MON CAP MARKED P.S.#27458

WITNESSES:  
 SOUTH POWER POLE, N&T, 41.55'  
 N30E 12" WILLOW, SPIKE, 62.60'  
 N70W 18" OAK, SPIKE, 143.30'  
 N25W 6" ELM, N&T, 109.91'

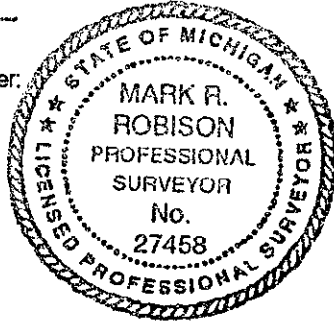

Signed by Mark R. Robison Date 11-29-96  
 Surveyor's Michigan License No. 27458