

GLADWIN COUNTY REMONUMENTATION

LAND CORNER RECORDATION CERTIFICATE  
 Filing Requirement of Act 74, Mich. P.A. 1970

LIBER 001 PAGE 123

For corners in

GLADWIN (County)	Located in:	Corner Code #
1. Public Land Survey	T 20N R 1E	H - 3
	T R	
	T R	
	T R	
2. Property Controlling in Section	S T R	
	S T R	
3. Miscellaneous Property in Sec.	S T R	
	S T R	

STATE OF MICHIGAN  
 GLADWIN COUNTY  
 FILED-REMONUMENTATION

2 DEC 96 3:28 P.M.

BONNIE K. HOUSE  
 REGISTER OF DEEDS

Register of Deeds Stamp & File Number

4. Lot No. \_\_\_\_\_, Recorded Plat \_\_\_\_\_  
 5. Private Claims \_\_\_\_\_

I, MARK ROBISON, in a field survey on November, 1996 do hereby state that under requirements of P.A. 74, Michigan P.A. of 1970, the corner points mentioned in lines 1 and 2 above were in conformance with regulations and rules therefore as required in the current manual of survey instructions of the United States Department of the Interior, Bureau of Land Management or by a decree of a Court of Law and /or that the corner points mentioned in lines 3, 4 and 5 above were in conformance with the rules of the Michigan Board of Land Surveyors or by a Decree of a Court of Law; established, re-established, monumented, recovered, found as expressed below:

NOTE: Not more than 2 corners, all in the same town and range, may be recorded on this certificate.

	A	B	C	D	E	F	G	H	I	J	K	L	M
1													
2	6		5		4			3		2		1	
3								●					
4	7		8		9			10		11		12	
5													
6	18		17		16			15		14		13	
7													
8	19		20		21			22		23		24	
9													
10	30		29		28			27		26		25	
11													
12	31		32		33			34		35		36	
13													

A. Description of original monument and accessories and/or subsequent restoration:

1846 JOHN MULLETT SET POST  
 WIT.-(1)HEMLOCK 10 S10W 74  
 (2)HEMLOCK 12 N12E 6  
 1849-59 MSHD 3/4" PIPE  
 WIT.-(3)N02E 8" APPLE 127.55  
 (4)N04E FE POST 36.15  
 (5)S04E P.P. 62.54  
 (6)S30W 14" APPLE 70.63  
 (7)S60W 10"APPLE 82.64  
 1983 HENNING SURVEY 1/2" BAR  
 WIT.-NONE

1973 PAUL LAPHAM LCRC #75  
 FOUND 1/2" PIPE  
 WIT.-(8)NORTH 37.47 COR FE POST  
 (9)SOUTH 32.59 COR FE POST  
 (10)S45W 93.03 6" APPLE  
 1973 PAUL LAPHAM-WORKING DRAWING & SEC SUBD  
 1973 PAUL LAPHAM SURVEY WIT.-SAME AS  
 1978 PAUL LAPHAM SURVEY WIT.-SAME AS  
 1981 PAUL LAPHAM SURVEY WIT.-SAME AS  
 1993 NORSTAR LCRC #353 FOUND CAPPED PIPE  
 WIT.-(11)SOUTH 64.80 P.P.

(12)N05E 38.63 STEEL FE POST  
 (13)S45W 44.57 CAPPED IRON

APPROVED LAND CORNER  
 P.A. 915 of 1990  
 Gladwin County

Co. Rep. John M. Megeen  
 Date 11/6/96

B. Description of corner evidence found and/or method applied in restoring or reestablishing corner:


FOUND 3/4" PIPE IN C/L ROAD 2' EAST OF FENCE NORTH. FOUND (10), N&T; REC. & MEAS. 93.03. FOUND (11), SPIKE; REC. & MEAS. 64.60. FOUND (13), POOR CONDITION; MEAS. 44.65, REAC. 44.57. FOUND (3) 10" APPLE (POOR); MEAS. 127.4+/- TO CENTER TREE, REC 127.55. FOUND (6) 18" APPLE (POOR); MEAS. 70.3+/- TO CENTER TREE, REC. 70.63.

SEE DOSSIER FOR DETAILED REPORT.

C. Description of monument for corner and accessories established to perpetuate locating the position of the corner:

H-3: 1/4 CORNER COMMON TO SECTIONS 3 & 10  
 SET 5/8" X 36" REROD WITH GLADWIN RE-MON CAP MARKED P.S.#27458

WITNESSES:  
 SOUTH C.I. #9433 33.00'  
 N30E 2" PINE, N&T, 80.75'  
 S45W 6" APPLE, N&T, 93.03'  
 SOUTH POWER POLE, SPIKE, 64.60'

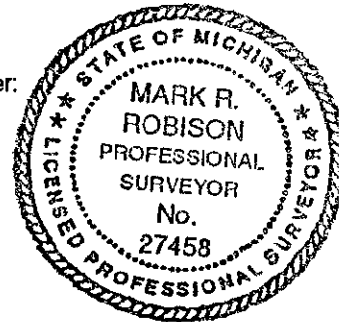

Signed by Mark R. Robison  
 Surveyor's Michigan License No. 27458

Date 11-29-96