

DEC 16 1996

COMMISSION

GLADWIN COUNTY REMONUMENTATION

LAND CORNER RECORDATION CERTIFICATE
Filing Requirement of Act 74, Mich. P.A. 1970

LIBER 001 PAGE 124

For corners in

GLADWIN

(County)

Located In:

Corner Code #

1. Public Land Survey

T	20N	R	1E	H - 5
T		R		
T		R		
T		R		
S		T	R	
S		T	R	
S		T	R	
S		T	R	

2. Property Controlling in Section

3. Miscellaneous Property in Sec.

4. Lot No. _____, Recorded Plat _____
5. Private Claims _____

STATE OF MICHIGAN
GLADWIN COUNTY
FILED-REMONUMENTATION

2 DEC 96 3:28 P.M.

DONNIE K. HOUSE
REGISTER OF DEEDS
Register of Deeds Stamp & File Number

I, MARK ROBISON, in a field survey on November, 1996, do hereby state that under requirements of P.A. 74, Michigan P.A. of 1970, the corner points mentioned in lines 1 and 2 above were in conformance with regulations and rules therefore as required in the current manual of survey instructions of the United States Department of the Interior, Bureau of Land Management or by a decree of a Court of Law and /or that the corner points mentioned in lines 3, 4 and 5 above were in conformance with the rules of the Michigan Board of Land Surveyors or by a Decree of a Court of Law, established, re-established, monumented, recovered, found as expressed below:

NOTE: Not more than 2 corners, all in the same town and range, may be recorded on this certificate.

	A	B	C	D	E	F	G	H	I	J	K	L	M
1													
2	6		5		4		3		2		1		
3													
4	7		8		9		10		11		12		
5													
6	18		17		16		15		14		13		
7													
8	19		20		21		22		23		24		
9													
10	30		29		28		27		26		25		
11													
12	31		32		33		34		35		36		
13													

A. Description of original monument and accessories and/or subsequent restoration:

1848 JOHN MULLETT
SET 1/4 POST
WIT.-(1)BEECH 8 S37W 16
(2)B. ASH 10 N35E 22

WIT.-(5)8" APPLE N2E 127.55
(6)P.P S4E 82.54
(7)F. POST N4E 36.15
(8)14" APPLE S30W 70.63

1963 HENNING SURVEY
SET 1/2" BAR
WIT.-(3)8" APPLE S51W 49.8
(4)4" TRIPLE MAPLE N21W 41.0

1973 PAUL LAPHAM L.C.R.C.#75
FOUND 1/2" BAR
WIT.-(9)S30E 23.80 8" OAK
(10)S 40W 31.23 CLUMP 4" MAPLE
(11)N60W 27.68 8" PINE

1973 PAUL LAPHAM-WORKING DRAWING & SECTION SUBDIVISIONS

1995 PAUL LAPHAM SURVEY
FOUND 1/2" ROD
WIT.-(12)N15E 44.30 N&T IN 6" W. OAK
(13)N40W 53.80 N&T IN 10" W. OAK
(14)S50W 50.20 N&T IN 12" MAPLE
(15)S05E 51.50 N&T IN 12" OAK

UNKNOWN EDMANDS ENG.

B. Description of corner evidence found and/or method applied in restoring or reestablishing corner:

FOUND 1/2" X 18" REROD 8" N OR C/L UNIMPROVED COUNTY ROAD. FOUND (4); MEAS. 41' TO LARGEST MAPLE. FOUND (9); MEAS. 23.6 TO BLAZE, REC. 23.6. FOUND (10); MEAS. 31.3 TO BLAZE, REC. 31.23. FOUND (12) & (13) AS RECORDED IN PAUL LAPHAM SURVEY. SET GLADWIN RE-MON FROM FOUND IRON & WITNESSES.

APPROVED LAND CORNER

P.A. 74, 1970
Gladwin County


SEE DOSSIER FOR DETAILED REPORT.

Co. Rep. Mark Robison
Date 11/6/96

C. Description of monument for corner and accessories established to perpetuate locating the position of the corner:

H-5: 1/4 CORNER COMMON TO SECTIONS 10 & 15
SET 5/8" X 36" REROD WITH GLADWIN RE-MON CAP MARKED P.S.#27458

WITNESSES:
N15E 6" W. OAK, N&T, 44.30'
N40W 10" W. OAK, N&T, 53.80'
S50W 12" MAPLE, N&T, 50.15'
S05E 12" OAK, N&T, 51.45'

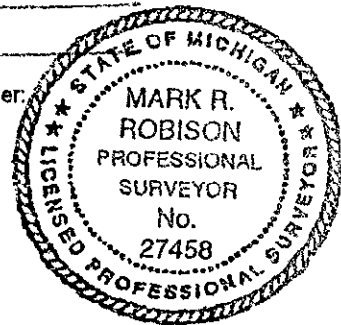

Signed by Mark R. Robison
Surveyor's Michigan License No. 27458

Date 11-29-96