

DEC 16 1996

COMMISSION

GLADWIN COUNTY REMONUMENTATION

LAND CORNER RECORDATION CERTIFICATE
Filing Requirement of Act 74, Mich. P.A. 1970

LIBER 001 PAGE 125

For corners in

<u>GLADWIN</u> (County)	Located In:	Corner Code #
1. Public Land Survey	T <u>20N</u> R <u>1E</u>	<u>1 - 3</u>
	T <u> </u> R <u> </u>	<u> </u>
	T <u> </u> R <u> </u>	<u> </u>
	T <u> </u> R <u> </u>	<u> </u>
2. Property Controlling in Section	S <u> </u> T <u> </u> R <u> </u>	<u> </u>
	S <u> </u> T <u> </u> R <u> </u>	<u> </u>
3. Miscellaneous Property in Sec.	S <u> </u> T <u> </u> R <u> </u>	<u> </u>
	S <u> </u> T <u> </u> R <u> </u>	<u> </u>

STATE OF MICHIGAN
GLADWIN COUNTY
FILED-REMONUMENTATION

2 DEC 96 3:28 P.M.


BONNIE K. HOUSE
REGISTER OF DEEDS

Register of Deeds Stamp & File Number

4. Lot No. _____, Recorded Plat _____
5. Private Claims _____

I, MARK ROBISON, in a field survey on November, 1996 do hereby state that under requirements of P.A. 74, Michigan P.A. of 1970, the corner points mentioned in lines 1 and 2 above were in conformance with regulations and rules therefore as required in the current manual of survey instructions of the United States Department of the Interior, Bureau of Land Management or by a decree of a Court of Law and/or that the corner points mentioned in lines 3, 4 and 5 above were in conformance with the rules of the Michigan Board of Land Surveyors or by a Decree of a Court of Law; established, re-established, monumented, recovered, found as expressed below:

NOTE: Not more than 2 corners, all in the same town and range, may be recorded on this certificate.

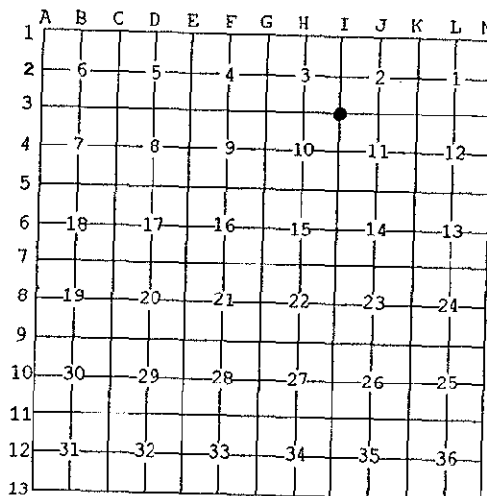

A. Description of original monument and accessories and/or subsequent restoration:

- 1846 JOHN MULLETT SECTION CORNER
WIT.-(1)BEECH 20 N55E 31
(2)BEECH 8 S41W 29
FOUND CORNER PAVT BOX
WIT.-(4)14" HEMLOCK S64W 100.5
(5)12" HEMLOCK S53 1/2E 123.5
(6)12" HEMLOCK N26E 103.5
- 1907 JOHN KNOX SURVEY
SET CEDAR STAKE AND WAGON SKEIN IN NEST OF STONES
WIT.-(3)ELM 10" S20W 5
1973 PAUL LAPHAM-WORKING DRAWING & SECTION SUBDIVISION
- 1963 HENNING SURVEY
1978 PAUL LAPHAM SURVEY
FOUND 1/2" IRON IN M.S.H.D. MON BOX
WIT.-SAME AS (4),(5)&(6)

1979 PAUL LAPHAM L.C.R.C.#223
FOUND 1/2" IRON MON BOX
WIT.-SAME AS (4),(5)&(6)

APPROVED LAND CORNER
P.A. 345 of 1990
Gladwin County

Co. Rep. Mark Robison
Date 11/6/96

B. Description of corner evidence found and/or method applied in restoring or reestablishing corner:


FOUND 3/4" IRON BAR IN M.S.H.D. MON BOX IN C/L HWY 30, T-ROAD NORTH. FOUND (4)-18" HEMLOCK WITH SHOULDER & CROWN BLAZE (OLD). FOUND (5)-18" HEMLOCK WITH SHOULDER & CROWN BLAZE (OLD). FOUND (6)-18" HEMLOCK WITH SHOULDER & CROWN BLAZE (OLD). ACCEPTED 3/4" IRON BAR. SET GLADWIN RE-MON CAP ON FOUND IRON.

SEE DOSSIER FOR DETAILED REPORT.

C. Description of monument for corner and accessories established to perpetuate locating the position of the corner:

I-3: CORNER COMMON TO SECTIONS 2, 3, 10 & 11
SET GLADWIN RE-MON CAP MARKED P.S.#27458 ON FOUND 3/4" IRON BAR IN MONUMENT BOX

- WITNESSES:
S64W 18" HEMLOCK, N&T, 100.42'
S53 1/2E 18" HEMLOCK, N&T, 103.25'
N26E 18" HEMLOCK, N&T, 123.30'
- S30W 20" OAK, N&T, 54.95'
NORTH, P.K. NAIL, 2.0'
EAST, P.K. NAIL, 2.0'

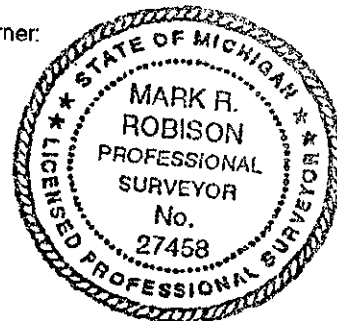

Signed by Mark R. Robison
Surveyor's Michigan License No. 27458

Date 11-29-96