

DEC 16 1996

COMMISSION

GLADWIN COUNTY REMONUMENTATION

LAND CORNER RECORDATION CERTIFICATE  
Filing Requirement of Act 74, Mich. P.A. 1970

LIBER 001 PAGE 126

For corners in

GLADWIN (County)	Located In:	Corner Code #
1. Public Land Survey	T 20N R 1E	1 - 4
	T R	
	T R	
	T R	
2. Property Controlling in Section	S T R	
	S T R	
3. Miscellaneous Property in Sec.	S T R	
	S T R	

STATE OF MICHIGAN  
GLADWIN COUNTY  
FILED-REMONUMENTATION  
2 DEC 96 3:28 P.M.  
BONNIE K. HOUSE  
REGISTER OF DEEDS

Register of Deeds Stamp & File Number

4. Lot No. \_\_\_\_\_, Recorded Plat \_\_\_\_\_  
5. Private Claims \_\_\_\_\_

I, MARK ROBISON, in a field survey on November, 1996 do hereby state that under requirements of P.A. 74, Michigan P.A. of 1970, the corner points mentioned in lines 1 and 2 above were in conformance with regulations and rules therefore as required in the current manual of survey instructions of the United States Department of the Interior, Bureau of Land Management or by a decree of a Court of Law and/or that the corner points mentioned in lines 3, 4 and 5 above were in conformance with the rules of the Michigan Board of Land Surveyors or by a Decree of a Court of Law; established, re-established, monumented, recovered, found as expressed below:

NOTE: Not more than 2 corners, all in the same town and range, may be recorded on this certificate.

	A	B	C	D	E	F	G	H	I	J	K	L	M
1													
2	6		5		4		3		2		1		
3													
4	7		8		9		10		11		12		
5													
6	18		17		16		15		14		13		
7													
8	19		20		21		22		23		24		
9													
10	30		29		28		27		26		25		
11													
12	31		32		33		34		35		36		
13													

A. Description of original monument and accessories and/or subsequent restoration:

- 1846 JOHN MULLETT  
SET 1/4 POST  
WIT.-(1)CEDAR 10 N60W 36  
(2)W. PINE 14 S48E 29
- 1907 JOHN KNOX SURVEY  
SET CEDAR STAKE 3" X 3" X 3"  
WIT.-(3)PINE STUMP 28" N78 1/2W 74 LKS
- 1963 HENNING  
SET 1/2" BAR
- WIT.-(4)8" MAPLE S67E 71.2  
(5)8" TWIN BIRCH N27E 63.5
- 1973 PAUL LAPHAM-WORKING DRAWING & SECTION SUBDIVISION
- 1995 PAUL LAPHAM SURVEY  
SET CAPPED IRON  
WIT.-(6)N35E 64.20, N&T, 8" W. PINE  
(7)WEST 18.76, N&T, 8" CEDAR  
(8)S85E 19.18, N&T, 6" SPRUCE

(9)S35W 33.67, N&T, 12" MAPLE

APPROVED LAND CORNER  
P.A. 245 of 1990  
Gladwin County

Co. Rep. Mark Robison  
Date 11/16/96

B. Description of corner evidence found and/or method applied in restoring or reestablishing corner:


FOUND 1/2" REROD IN C/L SINGLE TRACK ROAD. FOUND (4)-SHOULDER BLAZE; MEAS. 72.3+- 12" MAPLE, NO CROWN BLAZE. FOUND (6),(7),(8)&(9) AS REC. & MEAS. SET GLADWIN RE-MON FROM FOUND IRON & WITNESSES.

SEE DOSSIER FOR DETAILED REPORT.

C. Description of monument for corner and accessories established to perpetuate locating the position of the corner:

I-4: 1/4 CORNER COMMON TO SECTIONS 10 & 11  
SET 5/8" X 36" REROD WITH GLADWIN RE-MON CAP MARKED P.S.#27458

- WITNESSES:  
N35E 8" W. PINE, N&T, 64.20'  
WEST 8" CEDAR, N&T, 18.76'  
S85E 6" SPRUCE, N&T, 19.18'  
S35W 12" MAPLE, N&T, 33.67'

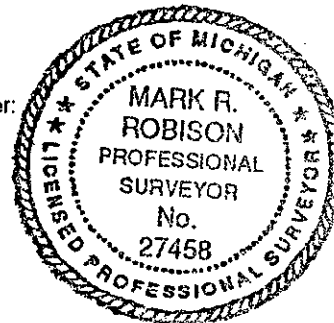

Signed by Mark R. Robison  
Surveyor's Michigan License No. 27458

Date 11-29-96