

DEC 1 6 1996

COMMISSION

GLADWIN COUNTY REMONUMENTATION

LAND CORNER RECORDATION CERTIFICATE
Filing Requirement of Act 74, Mich. P.A. 1970

LIBER 001 PAGE 127

STATE OF MICHIGAN
GLADWIN COUNTY
FILED-REMONUMENTATION

2 DEC 96 3:29 P.M.

BONNIE K. HOUSE
REGISTER OF DEEDS

Register of Deeds Stamp & File Number

For corners in

GLADWIN (County)	Located In:	Corner Code #
1. Public Land Survey	T 20N R 1E	1 - 5
	T R	
	T R	
	T R	
2. Property Controlling in Section	S T R	
	S T R	
3. Miscellaneous Property in Sec.	S T R	
	S T R	

4. Lot No. _____, Recorded Plat _____
5. Private Claims _____

I, MARK ROBISON, in a field survey on November, 1996, do hereby state that under requirements of P.A. 74, Michigan P.A. of 1970, the corner points mentioned in lines 1 and 2 above were in conformance with regulations and rules therefore as required in the current manual of survey instructions of the United States Department of the Interior, Bureau of Land Management or by a decree of a Court of Law and /or that the corner points mentioned in lines 3, 4 and 5 above were in conformance with the rules of the Michigan Board of Land Surveyors or by a Decree of a Court of Law, established, re-established, monumented, recovered, found as expressed below:

NOTE: Not more than 2 corners, all in the same town and range, may be recorded on this certificate.

	A	B	C	D	E	F	G	H	I	J	K	L	M
1													
2	6		5		4		3		2		1		
3													
4	7		8		9		10		11		12		
5													
6	18		17		16		15		14		13		
7													
8	19		20		21		22		23		24		
9													
10	30		29		28		27		26		25		
11													
12	31		32		33		34		35		36		
13													

A. Description of original monument and accessories and/or subsequent restoration:

1846 JOHN MULLETT
SET POST
WIT.-(1)HEMLOCK 26" N48E 28
(2)HEMLOCK 16" S14W 34

1963 HENNING SURVEY
SET 1/2" BAR IN C/L OF ROADS

1907 JOHN KNOX SURVEY
SET COR. SEC. 10, 11, 14 & 15
4' X 4" X 4" CEDAR STAKE
WIT.-(3)PINE STUMP 24"
N36 DEG. 30 MIN. E 1.54 LKS

1973 PAUL LAPHAM L.C.R.C.#75
FOUND 1/2" BAR
WIT.-(4)S50W 82.53 CLUMP 6" CHERRY
(5)S10W 69.58 TRIPLE 12" OAK
(6)N70E 88.55 12" OAK

1995 PAUL LAPHAM SURVEY
FOUND 1/2" IRON
WIT.-(7)S50W 82.90, N&T, IN TREE STUMP
(8)S45E 43.65, N&T, 8" POPLAR
(9)N40E 74.75, N&T, 5" OAK
(10)N40W 94.85, N&T, 6" POPLAR

1973 PAUL LAPHAM-WORKING DRAWING & SECTION SUBDIVISION

B. Description of corner evidence found and/or method applied in restoring or reestablishing corner:

FOUND 1/2" IRON AT INTERSECTION OF UNIMPROVED COUNTY ROAD, 5' SOUTH OF E-W ROAD. FOUND (4); MEAS. 82.50, REC. 82.53. FOUND (7),(8),(9)&(10). SET GLADWIN RE-MON FROM FOUND CORNER & WITNESSES.

APPROVED AND CORNER
P.A. 74 of 1970
Gladwin County


SEE DOSSIER FOR DETAILED REPORT.

Co. Rep. Mark Robison
Date 11/6/96

C. Description of monument for corner and accessories established to perpetuate locating the position of the corner:

I-5: CORNER COMMON TO SECTIONS 10, 11, 14 & 15
SET 5/8" X 3/8" REROD WITH GLADWIN RE-MON CAP MARKED P.S.#27458

WITNESSES:
S50W TREE STUMP, N&T, 82.90'
S45E 8" POPLAR, N&T, 43.65'
N40E 5" OAK, N&T, 74.75'
N40W 6" POPLAR, N&T, 94.85'

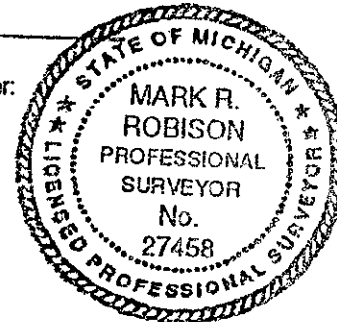

Signed by Mark R. Robison
Surveyor's Michigan License No. 27458

Date 11-29-96