

**SURVEY & REMONUMENTATION**

**OCT 23 1998**

GLADWIN County Remonumentation

**SECTION**

**LAND CORNER RECORDATION CERTIFICATE**  
Filing Requirement of Act 74, Mich. P.A. 1970

LIBER **001** PAGE **209**

For corners in

<u>GLADWIN</u> (County)	Located in:	Corner Code #
1. Public Land Survey	T20N R01E	M-9
	T R	
	T R	
	T R	
2. Property Controlling in Section	S T R	
	S T R	
3. Miscellaneous Property in Sec.	S T R	
	S T R	

STATE OF MICHIGAN  
GLADWIN COUNTY  
FILED-CORNER

13 OCT 1998 12:43:48 PM

BONNIE K. HOUSE  
REGISTER OF DEEDS

Register of Deeds Stamp & File Number

4. Lot No. \_\_\_\_\_, Recorded Plat \_\_\_\_\_  
5. Private Claims \_\_\_\_\_

I, Mark R Robison, in a field survey on April, 1998, do hereby state that under requirements of P.A. 74, Michigan P.A. of 1970, the corner points mention in lines 1 and 2 above were in conformance with regulations and rules therefore as required in the current manual of survey instructions of the United States Department of the Interior, Bureau of Land Management or by a decree of a Court of Law and/or that the corner points mentioned in lines 3, 4 and 5 above were in conformance with the rules of the Michigan Board of Land Surveyors or by a Decree of a Court of Law; established, re-established, monumented, recovered, found as expressed below:

	A	B	C	D	E	F	G	H	I	J	K	L	M
1													
2	6		5		4		3		2		1		
3													
4	7		8		9		10		11		12		
5													
6	18		17		16		15		14		13		
7													
8	19		20		21		22		23		24		
9													
10	30		29		28		27		26		25		
11													
12	31		32		33		34		35		36		
13													

**NOTE: Not more than 2 corners, all in the same town and range, may be recorded on this certificate**

A. Description of original monument and accessories and/or subsequent restoration:

- M-9:** 1837 Louis Mason Sq rd for Sec Post  
Cor, 1977 Lapham (LCRC#158) Fd Spike  
Sec 24 & 25, T20N, R1E Wit-(6)N70E 46.19 10" Maple  
Wit-(1)Pine 8 N85W 25 Lks (7)N50W 44.34 10" Maple  
(2)Do 14 N37W 19 Lks (8)S40W 58.34 6" Maple
- 1966 Henning Restored Cor with 1/2" Bar  
Wit-(3)10" Twin Maple S33W 54.5  
(4)10" R. Oak West 57.3  
(5)8" R. Oak N32E 74.0
- 1996 DNR (LCRC#376)  
Fd Lg Nail, Replaced with 5/8" x 36" Rod  
Wit-(9)7" Oak S87E 33.13  
(10)14" Quad-Maple S26E 54.58  
(11)13" Triple Maple N79W 40.79  
(12)10" Poplar S63W 47.43  
(13)24" Oak N38E 73.68

B. Description of corner evidence found and/or method applied in restoring or reestablishing corner:

- M-9:** Found 5/8" x 36" DNR rerod, location of corner used by County Remonumentation.  
bent, 3 ft. South of centerline others, 50 ft. +/- North. (1977 Lapham LCRC#158  
of county road, along with lag Accepted corner and was not accepted)  
bolt. Corner set by DNR witnesses by DNR. Corner  
through retracement of 1967 agrees with Henning See dossier & LCRC#376 for  
survey by Henning to correct witnesses. Replaced bent rod additional information.  
with 5/8" x 36" Gladwin

C. Description of monument for corner and accessories established to perpetuate locating the position of the corner:


- M-9:** Corner common to Sections 24 & 25, on township line. Set 5/8" x 36" rerod with Gladwin County Remonumentation cap marked P.S.#27458.

APPROVED LAND CORNER

P.A. 345 of 1990  
Gladwin County

Co. Rep. [Signature]  
Date 8/11/98

Signed by [Signature]  
Surveyor's Michigan License No. 27458

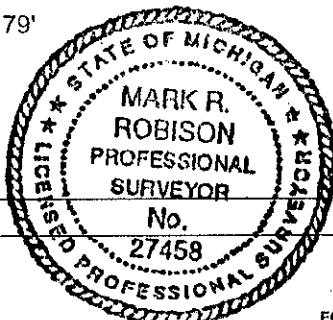

Date 10-5-98