

SURVEY & REMONUMENTATION

OCT 23 1998

GLADWIN County Remonumentation

SECTION

LAND CORNER RECORDATION CERTIFICATE
Filing Requirement of Act 74, Mich. P.A. 1970

LIBER **001** PAGE **211**

For corners in

<u>GLADWIN</u> (County)	Located in:	Corner Code #
1. Public Land Survey	T20N R01E	M-11
	T R	
	T R	
	T R	
2. Property Controlling in Section	S T R	
	S T R	
3. Miscellaneous Property in Sec.	S T R	
	S T R	

STATE OF MICHIGAN
GLADWIN COUNTY
FILED-CORNER

13 OCT 1998 12:44:19 PM

BONNIE K. HOUSE
REGISTER OF DEEDS

Register of Deeds Stamp & File Number

4. Lot No. _____, Recorded Plat _____
5. Private Claims _____

I, Mark R Robison, in a field survey on May _____, 1998 do hereby state that under requirements of P.A. 74, Michigan P.A. of 1970, the corner points mention in lines 1 and 2 above were in conformance with regulations and rules therefore as required in the current manual of survey instructions of the United States Department of the Interior, Bureau of Land Management or by a decree of a Court of Law and/or that the corner points mentioned in lines 3, 4 and 5 above were in conformance with the rules of the Michigan Board of Land Surveyors or by a Decree of a Court of Law; established, re-established, monumented, recovered, found as expressed below:

NOTE: Not more than 2 corners, all in the same town and range, may be recorded on this certificate

	A	B	C	D	E	F	G	H	I	J	K	L	M
1													
2	6	5	4	3	2	1							
3													
4	7	8	9	10	11	12							
	18	17	16	15	14	13							
8	19	20	21	22	23	24							
9													
10	30	29	28	27	26	25							
11													
12	31	32	33	34	35	36							
13													

A. Description of original monument and accessories and/or subsequent restoration:

M-11: 1837 Louis Mason - Set Sec Cor Post Wit-(1)Hem 7 S41W 15 Lks (2)Fir 5 N30W 2 Lks	Iron Wit-(6)South 23.87 to tag T. Pole (7)North East to tag in P.P.
1977 Lapham (working dwg & LCRC#158) Found 3/4" Pinch Iron Wit-(3)N25E 57.73 P.P. (4)N35E 61.70 P.P. (5)S10E 23.78 P.P.	1987 North Central Fd 1" Iron Wit-(8)Red Top F. Post N35W 72.15 (9)P.P. N33E 57.5 (10)Conc. Mon S62E 74.3 (11)F. Post S40W 42.4
1977 McGinnis (LCRC#162) Fd Pinch	1993 Lapham survey Fd 1" Iron Wit-same as (8),(9),(10)&(11)

1996 DNR (LCRC#376) Fd C.I.#9433
Wit-(12)P.P. S44W 55.39
(13)P.P. N40E 58.07
(14)Conc. Mon S56E 74.26

B. Description of corner evidence found and/or method applied in restoring or reestablishing corner:

M-11: Found capped iron in centerline of T-road, North-East-West. See dossier for additional information.
Excavated and found under capped iron a 1" x 24" pinch pipe 18" below the surface of the road. Agrees with witness (3), (9) & (13). Set Gladwin County Remonumentation in place of found 1" pinch pipe.

C. Description of monument for corner and accessories established to perpetuate locating the position of the corner:


M-11: Corner common to Sections 30 & 31, on township line. Set 5/8" x 36" rerod with Gladwin County Remonumentation cap marked P.S.#27458 in Monument Box.

Witnesses:
N35E Power Pole, nail & tag, 57.80'
S56E Concrete Monument 74.29'
S44W Power Pole, nail & tag, 55.41'
N45W 5/8" x 36" Iron 60.78'
P.K. nail 2 ft. North & East

APPROVED LAND CORNER
P.A. 345 of 1990
Gladwin County

Co. Rep. [Signature]
Date 8/14/98

Signed by [Signature]
Surveyor's Michigan License No. 27458

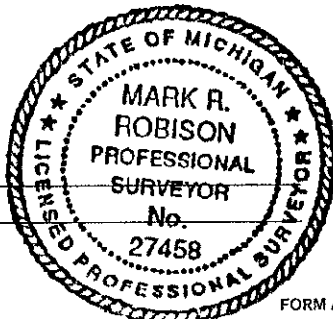

Date 10-5-98