

# LAND CORNER RECORDATION CERTIFICATE

FILING REQUIREMENT OF ACT 74, MICH. P.A.1970

FOR CORNERS OF--:	LOCATED IN--:	CORNER CODE NUMBER
1. PUBLIC LAND SURVEY	T. 20 N. R. 1 E.	K-6; K-7; L-6
2. PROPERTY CONTROLLING IN SECTION 13	T. 20 N. R. 1 E.	12
3. MISCELLANEOUS PROPERTY IN SECTION	T. N. S. R. E. W.	
4. LOT NO. _____, RECORDED PLAT _____		
5. PRIVATE CLAIMS _____		

REGISTER OF DEEDS STAMP AND FILING NUMBER

I, Kenneth J. Ostling, do hereby certify that under requirements of P.A. 74, Michigan P.A. of 1970, the corner points mentioned in lines 1 and 2 above were, in a field survey on February 14, 1977, 19\_\_\_\_, established, re-established, monumented, re-monumented, recovered or restored as expressed below and in conformance with regulations and rules therefore as required in the current manual of survey instructions of the United States Department of the Interior, Bureau of Land Management or by a decree of a court of law. Furthermore, that the corner points mentioned in lines 3, 4 and 5 above were, in a field survey on \_\_\_\_\_, 19\_\_\_\_, found, recovered, restored, established or re-established as expressed below and in conformance with the rules of the Michigan State Board of Registration for Land Surveyors or, by a Decree of a Court of law:

- A. Description of original monument and accessories and/or subsequent restoration:
- B. Description of corner evidence found and/or method applied in restoring or re-establishing corner:
- K-6 Set corner by proportionate measurement between section corners. Nothing found for previous corner.
  - K-7 Restored from Henning 1966 witnesses. Corner had been dozed out.
  - L-6 Set at computed intersection of true 1/4 lines.
  - 12 Set by standard survey procedure for subdivision of sections.

C. Description of monument for corner and accessories established to perpetuate locating the position of the corner:

K-6	K-7	L-6
Set DNR mon. & cedar post	Set 5/8" iron bar & Ced. post	Set 5/8" bar & cedar post
7" W. Pine S85°E 44.9	Henning's witness	8" Cedar N71°W 44.4
4" W. Pine S81°W 81.55	6" Maple N51°E 43.5	12" Cedar S80°W 52.75
	6" B. Oak N71°W 60.5	
		12
		Set 5/8" iron bar
		20" W. Pine N17°W 16.4
		18" Twn.W.Pine N66°W 47.9


SIGNED BY Kenneth J. Ostling DATE 6/7/77

SURVEYOR'S MICHIGAN REGISTRATION NO. 10068

FOR STATE AND UNITED STATES AGENCIES:

SIGNED BY \_\_\_\_\_ DATE \_\_\_\_\_

APPROVED AND SIGNED BY \_\_\_\_\_ DATE \_\_\_\_\_

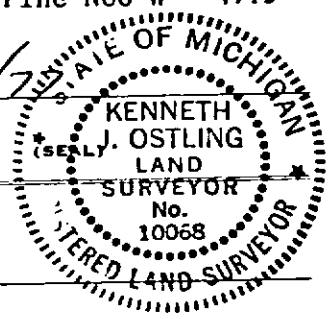

SURVEYOR'S MICHIGAN REGISTRATION NO. \_\_\_\_\_ GLADWIN COUNTY

MAY PLACE SKETCH ON BACK OR ATTACHED SHEET