LAND CORNER RECORDATION CERTIFICATE

Filing Requirement of Act 74, Mich. P.A. 1970

For corners in GLADWIN (County)

	Located In:	Corner Code ##
1. Public Land Survey	T 20N R 1E	L-8
	T ___ R ___	
	T ___ R ___	
	T ___ R ___	
2. Property Controlling	S 24 T ___ R ___	7, 12
in Section	S ___ T ___ R ___	
3. Miscellaneous	S ___ T ___ R ___	
Property in Sec.	S ___ T ___ R ___	

Register of Deeds Stamp & File Number

4. Lot No. _____ , Recorded Plat _____
5. Private Claims _____

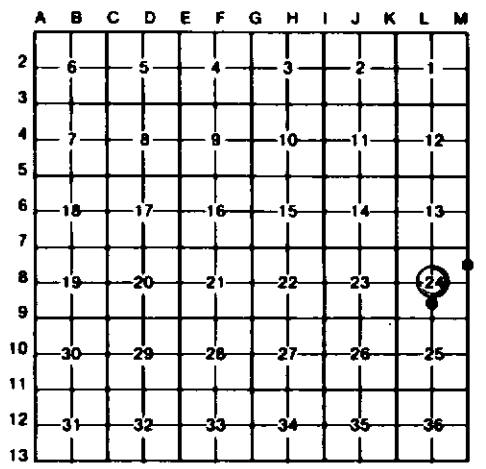

I, CARL T. KIISKILA , in a field survey on DECEMBER 20, , 19 94 , do hereby certify that under requirements of P.A. 74, Michigan P.A. of 1970, the corner points mentioned in lines 1 and 2 above were in conformance with regulations and rules therefore as required in the current manual of survey instructions of the United States Department of the Interior, Bureau of Land Management or by a decree of a Court of Law and/or that the corner points mentioned in lines 3, 4 and 5 above were in conformance with the rules of the Michigan Board of Land Surveyors or by a Decree of a Court of Law; established, re-established, monumented, re-monumented, recovered, found as expressed below:

NOTE: Not more than 4 corners, all in the same town and range, may be recorded on this certificate.

A. Description of original monument and accessories and/or subsequent restoration:

L-8 7 12

(NO EVIDENCE OF G.L.O. CORNER, B.T'S, LINE TREES & TOPOGRAPHY, AS CALLED OUT IN THE G.L.O. LINE NOTES; UNLESS NOTED IN ITEM "B" BELOW.)

B. Description of corner evidence found and/or method applied in restoring or reestablishing corner:

L-8	7	12
ESTABLISHED CENTER OF SEC 24 AT THE INTERSECTION OF 1/4 LINES BASED ON A SURVEY DONE BY RLS G.HENNING IN SEPT 1966.	ESTABLISHED THE NE CORNER OF THE SE 1/4 OF THE NE 1/4 OF SECTION 24 BY STANDARD PROCEDURE FOR SUBDIVISION OF A SECTION.	ESTABLISHED THE NW CORNER OF THE SW 1/4 OF THE SE 1/4 OF SECTION 24 BY STANDBARD PROCEDURE FOR SUBDIVISION OF A SECTION.

C. Description of monument for corner and accessories established to perpetuate locating the position of the corner:

L-8			7			12		
SET 5/8 X 32" CAPPED REROD W/CEDAR POST.			SET 5/8" X 32" REROD W/CAP.			SET 5/8" X 32" CAPPED REROD W/CEDAR POST.		
			14" W PINE	S49°E	44.58'			
14" MAPLE	N28°E	13.91'	14" W PINE	N53°E	42.93'	4" W PINE	S48°W	14.57'
13" W PINE	S67°E	36.10'	6" W PINE	N54°W	58.19'	4" W PINE	N38°W	34.69'
9" W PINE	S54°W	10.21'	3" ELM	S58°W	32.51'	6"-10" TW MAPLE	N32°E	37.21'
10" W PINE	N34°W	14.78'	CONC PLAT MON	S65°W	37.90'	6" MAPLE	S48°E	20.24'
ALL TREES HAVE UPPER BLAZES.			CEDAR POST	WEST	33'	ALL TREES HAVE UPPER BLAZES.		

STATE OF MICHIGAN
CARL KIISKILA
LAND SURVEYOR
No. 33981
LICENSED LAND SURVEYOR

Signed by Carl T Kiiskila Date 1-23-96

Surveyor's Michigan License No. 33981

FORM APPROVED BY MICHIGAN STATE BOARD OF LAND SURVEYORS, JAN. 28, 1971
REVISED MAY 14, 1975
REVISED JAN., 1983