

SURVEY & REMONUMENTATION

OCT 23 1998

GLADWIN County Remonumentation

SECTION

LAND CORNER RECORDATION CERTIFICATE
Filing Requirement of Act 74, Mich. P.A. 1970

LIBER **001** PAGE **214**

For corners in

<u>GLADWIN</u> (County)	Located in:	Corner Code #
1. Public Land Survey	T20N R02E	A-7
	T R	
	T R	
	T R	
2. Property Controlling in Section	S T R	
	S T R	
3. Miscellaneous Property in Sec.	S T R	
	S T R	

STATE OF MICHIGAN
GLADWIN COUNTY
FILED-CORNER

13 OCT 1998 12:44:57 PM

BONNIE K. HENSE
REGISTER OF DEEDS

Register of Deeds Stamp & File Number

4. Lot No. _____, Recorded Plat _____
5. Private Claims _____

I, Mark R Robison, in a field survey on May, 1998, do hereby state that under requirements of P.A. 74, Michigan P.A. of 1970, the corner points mention in lines 1 and 2 above were in conformance with regulations and rules therefore as required in the current manual of survey instructions of the United States Department of the Interior, Bureau of Land Management or by a decree of a Court of Law and/or that the corner points mentioned in lines 3, 4 and 5 above were in conformance with the rules of the Michigan Board of Land Surveyors or by a Decree of a Court of Law; established, re-established, monumented, recovered, found as expressed below:

NOTE: Not more than 2 corners, all in the same town and range, may be recorded on this certificate

A	B	C	D	E	F	G	H	I	J	K	L	M
1												
2	6	5		4		3		2		1		
3												
4	7	8		9		10		11		12		
5												
6	18	17		16		15		14		13		
7												
8	19	20		21		22		23		24		
9												
10	30	29		28		27		26		25		
11												
12	31	32		33		34		35		36		
13												

A. Description of original monument and accessories and/or subsequent restoration:
A-7: 1837 Louis Mason Iron
 Set Sec Post Cor Sec 13 & 24, T20N, R1E
 Wit-(1) Elui 8 S36W 33 Lks
 (2) W. Pine 24" N69W 21 Lks
 1908 CSR - 89.92 to Cor 18 & 19 - No Wit
 1967 Henning (survey & dwg) Drove 1" x 30" Pipe over Iron
 Fd & Restored 1/2" Iron Bar Wit-(10) 14" W. Pine S29E 64.98
 Wit-(3) 14" Twin Maple S33W 54.5 (11) P.P. S44W 40.24
 (4) 18" Red Oak West 57.3 (12) 14" W. Pine N37W 62.32
 (5) 8" Red Oak N32E 74.0 (13) Twin Maple N66E 44.59
 1977 Henning (survey & dwg) Wit-none
 1978 Lapham (survey & dwg) Fd 1/2" 1997 Lapham (survey & dwg) Fd 1/2" Iron

Wit-same as (10), (11), (12) & (13)

B. Description of corner evidence found and/or method applied in restoring or reestablishing corner:
A-7: Found 1" pipe (DNR 1" pipe drove over found 1/2" iron) 4 ft. West of centerline of North-South road. Corner agrees with 1967 survey by Henning (and others). Witnesses (9), (10) & (13) agree with found 1" Iron. Accepted corner as found. See dossier & LCRC#373 for additional information.


C. Description of monument for corner and accessories established to perpetuate locating the position of the corner:
A-7: Corner common to Sections 18 & 19, on township line. Set 1/2" x 8" rerod in found 1" pipe with Gladwin County Remonumentation cap marked P.S.#27458.

Witnesses:
 N66E Twin Maple, P.K. nail, 44.65'
 N37W 14" W. Pine, nail & tag, 73.75'
 N80W 12" W. Pine, nail & tag, 33.15'
 S45E 14" R. Pine, spike, 65.00'

APPROVED LAND CORNER
P.A. 345 of 1990
Gladwin County

Co. Rep. John Meyer
Date 8/11/98

Signed by Mark R. Robison
Surveyor's Michigan License No. 27458

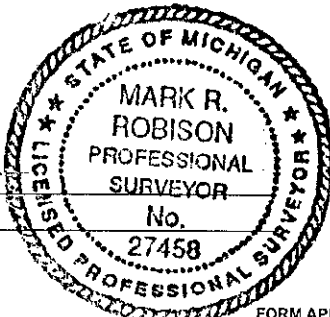

Date 10-5-98