

**SURVEY & REMONUMENTATION**

**OCT 23 1998**

GLADWIN County Remonumentation

**SECTION**

**LAND CORNER RECORDATION CERTIFICATE**  
Filing Requirement of Act 74, Mich. P.A. 1970

LIBER **001** PAGE **215**

For corners in

<u>GLADWIN</u> (County)	Located in:	Corner Code #
1. Public Land Survey	T20N R02E	A-8
	T R	
	T R	
	T R	
2. Property Controlling in Section	S T R	
	S T R	
3. Miscellaneous Property in Sec.	S T R	
	S T R	

STATE OF MICHIGAN  
GLADWIN COUNTY  
FILED-CORNER

13 OCT 1998 12:45:08 PM

DONNIE K. HOUSE  
REGISTER OF DEEDS

Register of Deeds Stamp & File Number

4. Lot No. \_\_\_\_\_, Recorded Plat \_\_\_\_\_  
5. Private Claims \_\_\_\_\_

I, Mark R Robison, in a field survey on April, 1998 do hereby state that under requirements of P.A. 74, Michigan P.A. of 1970, the corner points mention in lines 1 and 2 above were in conformance with regulations and rules therefore as required in the current manual of survey instructions of the United States Department of the Interior, Bureau of Land Management or by a decree of a Court of Law and/or that the corner points mentioned in lines 3, 4 and 5 above were in conformance with the rules of the Michigan Board of Land Surveyors or by a Decree of a Court of Law; established, re-established, monumented, recovered, found as expressed below:

**NOTE: Not more than 2 corners, all in the same town and range, may be recorded on this certificate**

1	A	B	C	D	E	F	G	H	I	J	K	L	M
2		6		5		4		3		2		1	
3													
4		7		8		9		10		11		12	
5													
6			18		17		16		15		14		13
7													
8			19		20		21		22		23		24
9													
10			30		29		28		27		26		25
11													
12			31		32		33		34		35		36
13													

**A. Description of original monument and accessories and/or subsequent restoration:**

- A-8:** 1837 Louis Mason Set 1/4 Post  
Wit-(1)W. Pine 14 S19W 25 Lks  
(2)Cedar 7 N45W 25 Lks
- 1966 Henning (survey) No Corner Set  
Calc midway & online
- 1995-96 DNR (dwg & LCRC#373)  
Set 5/8"x32" Capped Rod, midway & online  
Wit-(3)6" W. Pine N68E 58.46  
(4)18" W. Pine S78W 46.42  
(5)8" Tri-Maple S47E 43.49  
(6)4" W. Birch N55W 37.02

**B. Description of corner evidence found and/or method applied in restoring or reestablishing corner:**

- A-8:** Found 5/8" iron in centerline of county road, set by DNR midway on-line between found section corners. Agrees with 1967 survey by Henning. Accepted corner and witnesses as found in place. See dossier & LCRC#373 for additional information.

**C. Description of monument for corner and accessories established to perpetuate locating the position of the corner:**


- A-8:** W 1/4 Corner of Section 19, on township line. Set Gladwin County Remonumentation cap marked P.S.#27458 over found 5/8" x 32" rerod.

Witnesses:  
N68E 6" W. Pine, spike, 58.46'  
S78W 18" W. Pine, spike, 46.42'  
S47E 8" Triple Maple, spike, 43.49'  
N55W 4" W. Birch, spike, 37.02'  
West, Cedar Post, 21.68'

APPROVED LAND CORNER  
P.A. 345 of 1990  
Gladwin County

Co. Rep. [Signature]  
Date 8/11/98

Signed by [Signature]  
Surveyor's Michigan License No. 27458

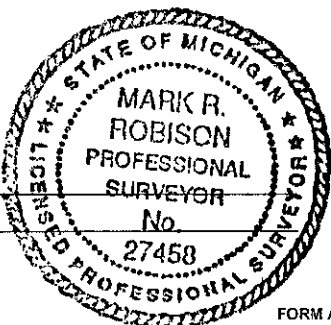

Date 10-5-98