

SURVEY & REMONUMENTATION

OCT 23 1998

SECTION

GLADWIN County Remonumentation
LAND CORNER RECORDATION CERTIFICATE
 Filing Requirement of Act 74, Mich. P.A. 1970

LIBER 001 PAGE 223

For corners in

GLADWIN
 (County)

Located in:

Corner Code #

- | | | |
|------------------------------------|-----------|-----|
| 1. Public Land Survey | T20N R02E | C-5 |
| | T R | |
| | T R | |
| | T R | |
| 2. Property Controlling in Section | S T R | |
| | S T R | |
| 3. Miscellaneous Property in Sec. | S T R | |
| | S T R | |

STATE OF MICHIGAN
 GLADWIN COUNTY
 FILED-CORNER

13 OCT 1998 12:46:45 PM

BONNIE K. HOUSE
 REGISTER OF DEEDS

Register of Deeds Stamp & File Number

4. Lot No. _____, Recorded Plat _____
 5. Private Claims _____

I, Mark R Robison, in a field survey on May _____, 1998, do hereby state that under requirements of P.A. 74, Michigan P.A. of 1970, the corner points mention in lines 1 and 2 above were in conformance with regulations and rules therefore as required in the current manual of survey instructions of the United States Department of the Interior, Bureau of Land Management or by a decree of a Court of Law and/or that the corner points mentioned in lines 3, 4 and 5 above were in conformance with the rules of the Michigan Board of Land Surveyors or by a Decree of a Court of Law; established, re-established, monumented, recovered, found as expressed below.

	A	B	C	D	E	F	G	H	I	J	K	L	M
1													
2	6		5		4		3		2		1		
3													
4	7		8		9		10		11		12		
5													
6	18		17		16		15		14		13		
7													
8	19		20		21		22		23		24		
9													
10	30		29		28		27		26		25		
11													
12	31		32		33		34		35		36		
13													

NOTE: Not more than 2 corners, all in the same town and range, may be recorded on this certificate

A. Description of original monument and accessories and/or subsequent restoration:

- C-5: 1846 John Mullett
 Set Post Cor Sec's 7, 8, 17 & 18
 Wit-(1) Cedar S55W 16
 (2) Do 14 N68E 3

- LCRC#50
 3/8" rerod 0.4 W of centerline of road
 Wit-(6) S85E 37.25 nail in 18" Elm
 (7) N40W 43.22 nail in P.P.
 (8) S45W 36.9 Fence Post

- (13) 8" Ash S55W 69.60
 (14) 10" Ash S63E 37.15
 (15) 16" Ash N50E 68.17

- 1967 Henning dwg & wit Set 1/2" Iron Bar
 Wit-(3) 16" Elm S80W 37.2
 (4) 8" Elm N54E 50.8
 (5) P.P. N40W 42.6
 3/4" Bar North 34

- 1979 Lapham working dwg
 1980 Lapham survey Found 1/2" iron
 Wit-(9) N45E E. End CMP 25.60
 (10) S60E 10" Basswood 37.10
 (11) S45W S. End CMP 31.35

1972 Edmands Eng. road plan &

- 1996 DNR LCRC#371 Fd 1/2" Bar
 Wit-(12) P.P. N43W 44.62

B. Description of corner evidence found and/or method applied in restoring or reestablishing corner:
 See dossier for additional information.

- C-5: Found 1/2" x 18" rebar at intersection of county roads.
 Excavated and found no other corner. Agrees with witnesses (10), (12), (13) & (15). Also agrees with 1967 survey by Henning and 1980 survey by Lapham. Removed found corner and set Gladwin County Remonumentation.


C. Description of monument for corner and accessories established to perpetuate locating the position of the corner:
 C-5: Corner common to Sections 7, 8, 17 & 18. Set 5/8" x 36" rebar in Monument Box with Gladwin County Remonumentation cap marked P.S.#27458.

APPROVED LAND CORNER
 P.A. 345 of 1990
 Gladwin County

- Witnesses:
 S60E 12" Ash, spike, 37.15'
 N43W Power Pole, spike, 44.74'
 N50E 18" Ash, spike, 68.20'
 S55W 8" Ash, spike, 69.56'
 P.K. Nail 2 ft. North and East

Co. Rep. [Signature]
 Date 8/11/98

Signed by [Signature]
 Surveyor's Michigan License No. 27458

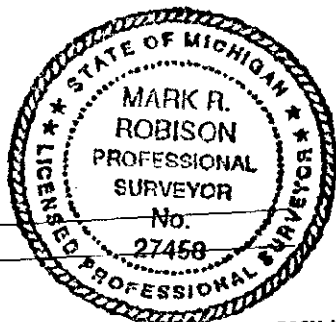

Date 10-5-98