

SURVEY & REMONUMENTATION

OCT 23 1998

GLADWIN County Remonumentation

LIBER **001** PAGE **227**

LAND CORNER RECORDATION CERTIFICATE
Filing Requirement of Act 74, Mich. P.A. 1970

SECTION

For corners in

<u>GLADWIN</u> (County)	Located in:	Corner Code #
1. Public Land Survey	T20N R02E	C-9
	T R	
	T R	
	T R	
2. Property Controlling in Section	S T R	
	S T R	
3. Miscellaneous Property in Sec.	S T R	
	S T R	

STATE OF MICHIGAN
GLADWIN COUNTY
FILED-CORNER

13 OCT 1998 12:47:33 PM

DONNIE K. HOUSE
REGISTER OF DEEDS

Register of Deeds Stamp & File Number

4. Lot No. _____, Recorded Plat _____
5. Private Claims _____

I, Mark R Robison, in a field survey on May, 1998, do hereby state that under requirements of P.A. 74, Michigan P.A. of 1970, the corner points mention in lines 1 and 2 above were in conformance with regulations and rules therefore as required in the current manual of survey instructions of the United States Department of the Interior, Bureau of Land Management or by a decree of a Court of Law and/or that the corner points mentioned in lines 3, 4 and 5 above were in conformance with the rules of the Michigan Board of Land Surveyors or by a Decree of a Court of Law, established, re-established, monumented, recovered, found as expressed below:

NOTE: Not more than 2 corners, all in the same town and range, may be recorded on this certificate

	A	B	C	D	E	F	G	H	I	J	K	L	M
1													
2	6		5			4		3		2		1	
3													
4	7		8			9		10		11		12	
5													
6	18		17			15		14		13			
7													
8	19		20			21		22		23		24	
9													
10	30		29			28		27		26		25	
11													
12	31		32			33		34		35		36	
13													

- A. Description of original monument and accessories and/or subsequent restoration:
- C-9: 1846 John Mullett
Set Post Cor Sec's 19, 20, 29 & 30
Wit-(1)Eliv 10 S46W 20
(2)B Ash 8 S48E 6
 - 1966 Edmands Eng road plans 1/2" Iron Rod
Wit-(3)Spike in 15" Elm SW 89.31
(4)Spike in 12" Cottonwood SE 76.70
 - 1976-77 Lapham Found cement nail (working dwg, survey & LCRC#158)
 - Wit-(5)West 41.52 Fence Post
(6)S35W 65.65 Fence Post
(7)S45E 41.06 6" Elm
 - 1991 McGinnis survey
Wit-same as (3) & (4)
1996 DNR working dwg & LCRC#375
Fd cement nail; Replaced w/ 1/2"x18" rebar
Wit-(11)Cor Fe Post N80W 37.73
(12)6" Ash S48E 46.81
(13)4" Ash N84E 63.78
(14)Fe Post N27W 63.78


- B. Description of corner evidence found and/or method applied in restoring or reestablishing corner:
- C-9: Found 1/2" rerod (DNR) in centerline of road North-South, opposite fence to West. Agrees with witnesses as recorded on LCRC#375, Gladwin County Records. Found (4); spike in 20" Poplar stub, recorded & measured 76.70 ft. Set Gladwin County Remonumentation in place of found iron. See dossier for additional information.

- C. Description of monument for corner and accessories established to perpetuate locating the position of the corner:
- C-9: Corner common to Sections 19, 20, 29 & 30. Set 5/8" x 36" rerod in Monument Box with Gladwin County Remonumentation cap marked P.S.#27458.
 - Witnesses:
S48E 6" Ash, spike, 46.81'
N84E 4" Ash, spike, 45.00'
West Corner Post, nail & tag, 37.15'
N25E 6" Ash, nail & tag, 72.62'
SE 20" Poplar Stub, spike, 76.70'
P.K. Nail 2 ft. North & East

APPROVED LAND CORNER
P.A. 345 of 1990
Gladwin County

Co. Rep. [Signature]
Date 8/14/98

Signed by [Signature]
Surveyor's Michigan License No. 27458

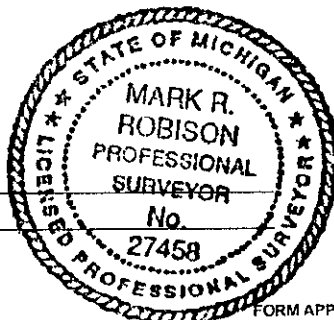

Date 10-5-98