

SURVEY & REMONUMENTATION

OCT 23 1998

GLADWIN County Remonumentation

SECTION

LAND CORNER RECORDATION CERTIFICATE
Filing Requirement of Act 74, Mich. P.A. 1970

LIBER 001 PAGE 229

For corners in

<u>GLADWIN</u> (County)	Located in:	Corner Code #
1. Public Land Survey	T20N R02E	C-11
	T R	
	T R	
	T R	
2. Property Controlling in Section	S T R	
	S T R	
3. Miscellaneous Property in Sec.	S T R	
	S T R	

STATE OF MICHIGAN
GLADWIN COUNTY
FILED-CORNER

13 OCT 1998 12:48:02 PM

BONNIE K. HOUSE
REGISTER OF DEEDS

Register of Deeds Stamp & File Number

4. Lot No. _____, Recorded Plat _____
5. Private Claims _____

I, Mark R Robison, in a field survey on May _____, 19_98_ do hereby state that under requirements of P.A. 74, Michigan P.A. of 1970, the corner points mention in lines 1 and 2 above were in conformance with regulations and rules therefore as required in the current manual of survey instructions of the United States Department of the Interior, Bureau of Land Management or by a decree of a Court of Law and/or that the corner points mentioned in lines 3, 4 and 5 above were in conformance with the rules of the Michigan Board of Land Surveyors or by a Decree of a Court of Law; established, re-established, monumented, recovered, found as expressed below:

NOTE: Not more than 2 corners, all in the same town and range, may be recorded on this certificate

1	A	B	C	D	E	F	G	H	I	J	K	L	M
2		6		5		4		3		2		1	
3													
4		7		8		9		10		11		12	
5													
6		18		17		16		15		14		13	
7													
8		19		20		21		22		23		24	
9													
10		30		29		28		27		26		25	
11													
12		31		32		33		34		35		36	
13													

A. Description of original monument and accessories and/or subsequent restoration:
C-11: 1846 John Mullett
 Set Post Sec's 29, 30, 31 & 32
 Wit-(1) Birch 6 N70W 11
 (2) Hemlock 12 S43E 9
 1964 Edmands Eng. road plans Set Iron
 Wit-(3) Tele Pole SW 147.0
 (4) NE Cor Pump Isle 92.75
 1968 Lapham survey Wit-none
 1977 Lapham LCRC#158 Fd 3/4" Pipe
 Wit-(5) S20W 59.22 S. End Guard Rail
 (6) N40E 35.33 N. End Guard Rail
 (7) N20E 82.66 Road Sign
 1977 Edmands Eng LCRC#162
 Found 1/2" x 1 1/2" Iron
 Wit-(8) NE Cor Pump Isle S45E 89.75
 (9) T. Pole West 147.00
 (10) 55.0 North to centerline road
 1995 Lapham survey
 Wit-same as (3), (4) & (5)

1996 DNR LCRC#377 Fd 3/4" Pipe
 Wit-(11) Sign Post N29E 79.9
 (12) S. End Guard Rail S20W 59.22
 (13) N. End Guard Rail N40E 35.33

B. Description of corner evidence found and/or method applied in restoring or reestablishing corner:
C-11: Found 1" Pipe in centerline of road, 1 ft. below bituminous surface (could not remove). Top of pipe agrees with witnesses (5), (6), (12) & (13). Measured 147.2 to face of telephone pole--witness#(3). Moved top of pipe and set Gladwin County Remonumentation from witnesses (5), (6) and original location of top of 1" Pipe.
 See dossier for additional information.


C. Description of monument for corner and accessories established to perpetuate locating the position of the corner:
C-11: Corner common to Sections 29, 30, 31 & 32. Set 5/8" x 36" rerod in Monument Box with Gladwin County Remonumentation cap marked P.S.#27458.

Witnesses:
 S20W E. End Guard Rail 59.22'
 S20W Utility pole, nail & tag, 147.85'
 S15E 4" Ash, nail & tag, 189.60'
 N15W Plug Center East Face Stan Pipe 77.10'
 N29E River Sign Post 79.90'
 P.K. Nail 2 ft. North & East

APPROVED LAND CORNER
 P.A. 345 of 1990
 Gladwin County

Co. Rep. [Signature]
 Date 8/11/98

Signed by [Signature]
 Surveyor's Michigan License No. 27458

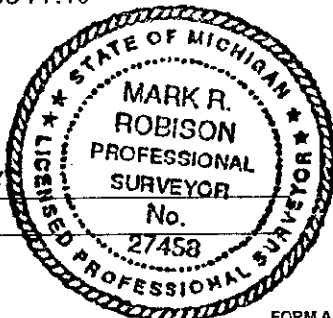

Date 10-5-98