


LAND CORNER RECORDATION CERTIFICATE

Filing Requirement of Act 74, Mich. PA 1970

For Corners In: <u>Gladwin</u> (County)	Located In _____	Corner Code # _____	
1. Public Land Survey	T <u>20N</u> R <u>2E</u>	<u>E11</u>	_____
	T _____ R _____	_____	_____
2. Property Controlling in Section	S _____ T _____ R _____	_____	_____
	S _____ T _____ R _____	_____	_____
3. Miscellaneous Property in Section	S _____ T _____ R _____	_____	_____
	S _____ T _____ R _____	_____	_____
4. Lot No: _____	Recorded Plat: _____		
5. Private Claims: _____			

Register of Deeds Stamp & File Number

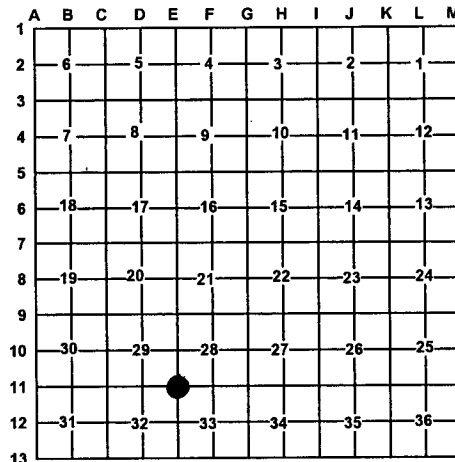

I, Craig W. McVean, in a field survey on March 6, 2006 do hereby state that under requirements of PA 74, Michigan PA of 1970, the corner points mentioned in lines 1 and 2 above were in conformance with regulations and rules therefore as required in the current manual of survey instructions of the United States Department of the Interior, Bureau of Land Management or by a decree of a Court of Law and/or that the corner points mentioned in lines 3, 4 and 5 above were in conformance with the rules of the Michigan Board of Land Surveyors or by a Decree of a Court of Law; established, re-established, monumented, recovered, found as expressed below:

NOTE: Not more than 2 corners, all in the same town and range, may be recorded on this certificate.

A. Description of original monument and accessories and/or subsequent restoration:

- E11 – J. Mullett – 1846 – Set Post
 Cedar 12" N85°E 10 L.
 Maple 12" S62°W 38 L.
 - CCC Notes – 1930's – North between 32 & 33 - 80:00 – Set Random post
 - Lapham & Assoc. Notes – R. L. Higgins – 1978 – Sec. 29 – Fd. SE at 5331.44' from the SW. N85°E 6.6' Fd. stump;
 SE 20.23' spike in Maple Clp.

B. Description of corner evidence found and/or method applied in restoring or re-establishing corner:

E11 – Section corner common to Sections 28, 29, 32 & 33, T20N, R2E - Fd. ½" x 18" rebar – 4' North of centerline of old overgrown E-W 2-track road probably from 1930's CCC Survey. Fits one Higgins Witness and the remains of the NE. Carl Kiiskila, PS and I both investigated the stump remains to ground at N85°E 6.6' from this ½" rebar and concluded the stp. was a Pine not a cedar. Could not accept Higgins iron as a original perpetuation. Couldn't find any other conclusive GLO evidence. Investigated GLO swamp calls from the ½" rebar and proportional distances as follows: 1) The ½" iron falls on the NW'ly edge of a swamp to the S & E and N. 2) To the NW is a transition zone between swamp and higher ground. GLO says "North 3 CH leave swamp". Swamp edge to N is mostly N-S so this is an inconclusive call. 3) GLO says "leave swamp – 1.16 West". Measured W 54'± 20' to edge of swamp transition zone. Also measure West 477'± 30' vs. 474' GLO to enter swamp. 4) Measured East 492'± 20' vs. 462' – GLO to "leave swamp". 5) Measure South 322'± 15' vs. 330' GLO to "leave swamp" and South 1189'± 30' vs. 1188' – GLO to "enter swamp". 6) The distance East is 5316.9' vs. 5287.9' – GLO to 'G11' and West 5336.9' vs. 5290.6' – GLO to 'C11'. 7) The distance South to 'E13' is 5115.8' vs. 5280' – GLO and North to 'E8' is 7948.6' vs. 7920' – GLO. Upon looking at all the evidence it appears the ½" iron rebar is located correctly N-S based on the GLO swamp calls South and the presence of the old CCC road. E-W the ½" iron is 8.6' East of a proportional E-W position. Could see no reason to move position 8.6' West since E-W swamp calls would probably indicate moving more East. Thus accepted ½" x 18" rebar as the best available evidence of the position of the original corner.

C. Description of monument for corner and accessories established to perpetuate locating the position of the corner:

- E11 – Replaced ½" x 18" rebar with Stamped 4" DNR aluminum cap on 1" x 3' long galv. iron pipe
 N4°E 162.61' to set N & T in E. side 34" W. Pine scribed 'XBT'
 S42°E 20.12' to set N & T in NE side 20" R. Maple (RLH)
 S5°E 38.08' to set N & T in E Side 10" R. Maple scribed 'XBT'
 S39°W 44.39' to set N & T in NW side 13" R. Maple scribed 'XBT'
 N46°W 83.46' to set N & T in SW side 10" R. Maple Clp – 4
 Set Blue Carsonite Post 1' West



Signed by: Craig W. McVean
 Surveyor's Michigan License No.: 39088

Date: 5/9/2007