
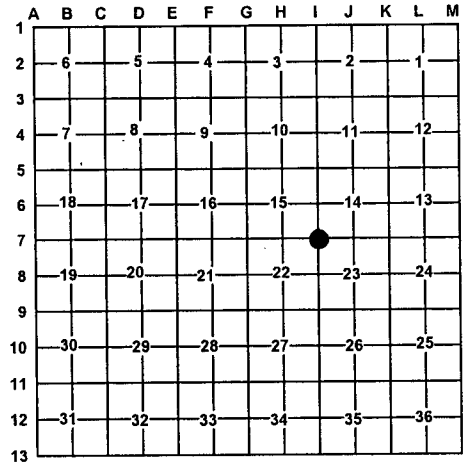


**LAND CORNER RECORDATION CERTIFICATE**  
Filing Requirement of Act 74, Mich. PA 1970

For Corners In: Gladwin (County)	Located In	Corner Code #
1. Public Land Survey	T <u>20N</u> R <u>2E</u>	<u>I-7</u>
	T _____ R _____	_____
2. Property Controlling in Section	S _____ T _____ R _____	_____
	S _____ T _____ R _____	_____
3. Miscellaneous Property in Section	S _____ T _____ R _____	_____
	S _____ T _____ R _____	_____
4. Lot No: _____	Recorded Plat: _____	
5. Private Claims: _____		

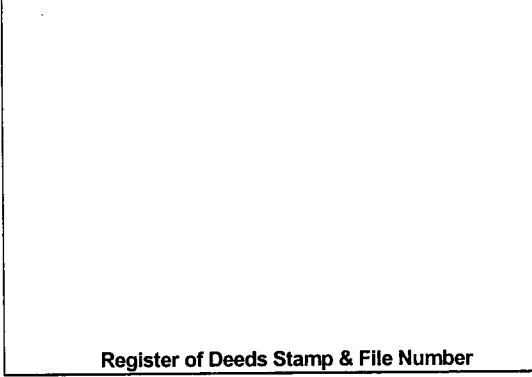

I, Craig W. McVean, in a field survey on Sept. 20, 2005 do hereby state that under requirements of PA 74, Michigan PA of 1970, the corner points mentioned in lines 1 and 2 above were in conformance with regulations and rules therefore as required in the current manual of survey instructions of the United States Department of the Interior, Bureau of Land Management or by a decree of a Court of Law and/or that the corner points mentioned in lines 3, 4 and 5 above were in conformance with the rules of the Michigan Board of Land Surveyors or by a Decree of a Court of Law; established, re-established, monumented, recovered, found as expressed below:

**NOTE: Not more than 2 corners, all in the same town and range, may be recorded on this certificate.**

A. Description of original monument and accessories and/or subsequent restoration:

- I-7 – GLO – Set Post – J. Mullett – 1846  
W. Pine 20" S50°E 35 L.  
W. Pine 14" N44°W 14 L.
- CSR – P. 105 – I. Knox – 1908  
Planted a cedar 3' x 3" x 3"; Pine stp. 18"  
N40°E 65; Pine stp. 22" S24°E 78
- CCC Notes – 1930's – East 80:18 – Set Random post  
North 238.16 Center E-W Rd. & 240.00 CH. – Set Random post
- LCRC # 387 – C.F. Roser – 1996 – Reest. by double distance  
from fd. SE Cor. Sec. 14 and reest. S ¼ cor. Sec. 14. Ctr. of  
29' wide E-W gravel rd. is 2' South. See Rec. Sur. L. 1, p. 698  
and our LCRC for 'J7' and 'K7'. Dr. 5/8" x 34" rerod w/ RLS Cap;  
12" W. Pine N25°W 61.5'; 6" W. Pine N35°E 67.1';  
14" W. Pine S55°E 77.8'; 7" R. Pine S25°W 49.3';  
North 45' to set Cedar post w/ loc. tag

B. Description of corner evidence found and/or method applied in restoring or re-establishing corner:

- I-7 – Sec. Corner common to Sections 14, 15, 22 & 23 – Fd. ½" x 3" capped iron in E-W Bit. Rd. – 2' N. of centerline. Removed and excavate down 0.8' and find DNR 5/8" CIR per Roser LCRC. Position of corner fits GLO proportion 1 Mile E & W closely. Appears CSR Survey in 1908 was for road alignment so corner near centerline at E-W road seems correct for latitude. CSR distances E & W are inconsistent with today's measurements. No GLO or CSR Witnesses found. DNR 5/8" CIR accepted as the best available evidence of the position of the original corner.

C. Description of monument for corner and accessories established to perpetuate locating the position of the corner:

- I-7 – Removed plastic DNR cap from 5/8" rebar and placed stamped 2 ½" Brass Cap on existing 5/8" rebar. Add Mon. Box  
S22°W 49.65' to set N & T in SE side 12" R. Pine (CFR)  
S52°E 78.46' to fd. dbl. head nail in NE side 18" W. Pine (CFR)  
N24°W 61.71' to set N & T in NE side 18" W. Pine (CFR)  
N36°E 67.16' to set N & T in NW side 11" W. Pine (CFR)  
North 45' to Cedar post with loc. tag (CFR)



Signed by: Craig W. McVean  
Surveyor's Michigan License No.: 39088

Date: 5/9/2007