

LAND CORNER RECORDATION CERTIFICATE


Filing Requirement of Act 74, Mich. PA 1970

For Corners In: Gladwin (County)	Located In	Corner Code #
1. Public Land Survey	T <u>20N</u> R <u>2E</u>	<u>K9</u>
	T _____ R _____	_____
2. Property Controlling in Section	S _____ T _____ R _____	_____
	S _____ T _____ R _____	_____
3. Miscellaneous Property in Section	S _____ T _____ R _____	_____
	S _____ T _____ R _____	_____
4. Lot No: _____	Recorded Plat: _____	
5. Private Claims: _____		

Register of Deeds Stamp & File Number

I, Craig W. McVean, in a field survey on Feb. 21, 2006 do hereby state that under requirements of PA 74, Michigan PA of 1970, the corner points mentioned in lines 1 and 2 above were in conformance with regulations and rules therefore as required in the current manual of survey instructions of the United States Department of the Interior, Bureau of Land Management or by a decree of a Court of Law and/or that the corner points mentioned in lines 3, 4 and 5 above were in conformance with the rules of the Michigan Board of Land Surveyors or by a Decree of a Court of Law; established, re-established, monumented, recovered, found as expressed below:

NOTE: Not more than 2 corners, all in the same town and range, may be recorded on this certificate.

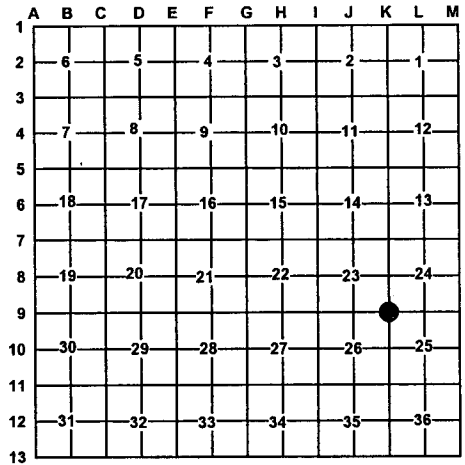

A. Description of original monument and accessories and/or subsequent restoration:


- | | |
|--|---|
| <p><u>K9</u> – GLO – Set Post – J. Mullett – 1846
Tamarack 12" N25°E 32 L.
Tamarack 18" S28° 13 L.
- CCC Notes – 1930's – West between Sec. 24 & 25 -
80:00 – Set Random post 2.26 W. & 39 S. of old post.
No Witnesses. North between 25-26; 159:22 Intersect E-W
random 160:00. Set random post.</p> | <p>- LCRC – P. 53 and Rec. Sur. L1, P. 239 – 240 –
S. S. Barnett – 1973
Set ½" pinched pipe
12" Poplar west 12.54'; 6" Poplar
S06°W 10.13'; 6" Maple N76°E 15.95'</p> |
|--|---|

B. Description of corner evidence found and/or method applied in restoring or re-establishing corner:

- K9 – Sec. Corner Common to Sec. 23, 24, 25 & 26 – No conclusive GLO evidence found. Couldn't locate old post noted by CCC but it appears to be too far East to be acceptable. Set DNR Mon. by Double proportion to GLO between found 'M9'; 'D9'; 'K7' and reest. 'K11'. Mon. is in grassy marsh 67'± 20' West of the swamp edge. GLO notes that corner should be on high ground but GLO topo calls are so inconsistent in this area didn't feel they could be relied on. DNR Mon. accepted as a careful and faithful reestablishment of the position of the original corner.
- Reference Pt. – S79°31'E 294.64' from 'K9' to set spike per Barnett's Rec. Survey that fits his Maple Witness. No evidence of ½" pinch pipe. Not sure how this position was established but somewhat fits 2 GLO topo calls as follows; Measured N. 105'± vs. 66' GLO to enter swamp and West 228' ± vs. 264' – GLO to enter swamp. Other topo call in the area do not fit from Barnett's position as follows: Measured East 186'± vs. 841.5' – GLO to enter swamp. Measured North 974'± vs. 858' – GLO to a sand Ridge. Being that Barnett's position is only 4953.1' vs. 5293.2' – GLO west of 'M9' and the GLO topo calls being inconsistent in this area didn't feel that Barnett's position was acceptable. Spike at Barnett position not utilized as 'K9' in this survey.

C. Description of monument for corner and accessories established to perpetuate locating the position of the corner:

- K9 – Set 4" DNR Alum. Cap on 1" x 5' long galv. iron pipe.
Set Blue Carsonite Post 1' SW
S65°E 104.19' to set N & T in N. side Tri. 15" R. Maple scribed 'XBT'
S38°E 61.87' to set N & T in SW side 5" Tamarack
S12°W 67.62' to set N & T in W. side 16" R. Maple scribed 'XBT'
N27°W 50.73' to set ½" x 24" rebar
S79°31'E 294.64' to set spike – Reference Pt.

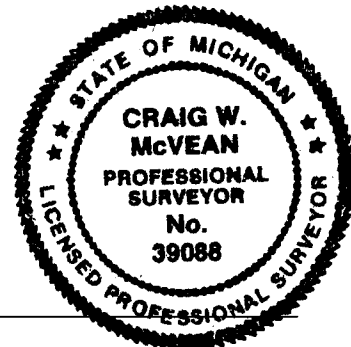

Signed by: Craig W. McVean
Surveyor's Michigan License No.: 39088

Date: 5/9/2007