

LAND CORNER RECORDATION CERTIFICATE

Filing Requirement of Act 74, Mich. PA 1970

For Corners In: Gladwin Located In _____ Corner Code # _____
(County)

1. Public Land Survey		T _____	R _____	
		T _____	R _____	_____
2. Property Controlling in Section	S <u>29</u>	T <u>20N</u>	R <u>2E</u>	<u>12</u>
	S <u>29</u>	T <u>20N</u>	R <u>2E</u>	<u>15</u>
3. Miscellaneous Property in Section	S _____	T _____	R _____	_____
	S _____	T _____	R _____	_____


Register of Deeds Stamp & File Number

4. Lot No: _____ Recorded Plat: _____

5. Private Claims: _____

I, Craig W. McVean, in a field survey on Mar. 8, 2006 do hereby state that under requirements of PA 74, Michigan PA of 1970, the corner points mentioned in lines 1 and 2 above were in conformance with regulations and rules therefore as required in the current manual of survey instructions of the United States Department of the Interior, Bureau of Land Management or by a decree of a Court of Law and/or that the corner points mentioned in lines 3, 4 and 5 above were in conformance with the rules of the Michigan Board of Land Surveyors or by a Decree of a Court of Law; established, re-established, monumented, recovered, found as expressed below:

NOTE: Not more than 2 corners, all in the same town and range, may be recorded on this certificate.

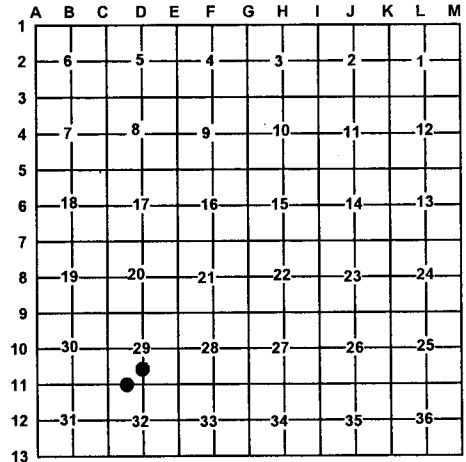

A. Description of original monument and accessories and/or subsequent restoration:

- 12 - None
- 15 - Rec. Sur - L. 1, p. 810 - 1978
R. L. Higgins - 1/2" x 18" steel bar set.

B. Description of corner evidence found and/or method applied in restoring or re-establishing corner:

- 12 - CS 1/16 Corner, Section 29 - Set stamped 2" Aluminum cap on 5/8" x 34" rebar per standard BLM procedure. S30° 130'± to 2-Track - NW & SE.
- 15 - W 1/16 corner common to Sections 29 & 32 - Fd. 1/2" x 18" capped rebar #21570 per Rec. Survey. 1/2" CIR accepted as the best available evidence of the position of the corner.

C. Description of monument for corner and accessories established to perpetuate locating the position of the corner:

- 12 - Stamped 2" Aluminum cap on 5/8" x 34" rebar
N61°W 16.36' to set N & T in SW side 3" R. Maple
S35°W 28.20' to set N & T in NW side 3" W. Pine
S49°E 31.73' to set N & T in NE side 3" R. Maple
N14°E 19.74' to set N & T in W. side 2" R. Maple
Set Blue Carsonite Post w/ location tag 1' SE
- 15 - Replaced 1/2" x 18" CIR w/ stamped 2" Aluminum cap on 5/8" x 34" rebar
N73°W 22.09' to set N & T in N. side 9" Elm
S68°E 21.41' to set N & T in N. side 5" Red Maple
N7°E 19.72' to set N & T in W. side 4" Elm
S36°W 27.08' to set N & T in SE side 4" Ash
Set Blue Carsonite Post w/ location tag 1' SE

Signed by: Craig W. McVean
Surveyor's Michigan License No.: 39088

Date: 5/9/2007

