LAND CORNER RECORDATION CERTIFICATE

Filing Requirement of Act 74, Mich. P.A. 1970

For corners in GLADWIN (County)

	Located In:	Corner Code ##
1. Public Land Survey	T 20N R 2E	J-7, K-6,
	T ___ R ___	K-7
	T ___ R ___	
	T ___ R ___	
2. Property Controlling	S 14 T ___ R ___	16
in Section	S ___ T ___ R ___	
3. Miscellaneous	S ___ T ___ R ___	
Property in Sec.	S ___ T ___ R ___	

Register of Deeds Stamp & File Number

4. Lot No. _____ , Recorded Plat _____
5. Private Claims _____

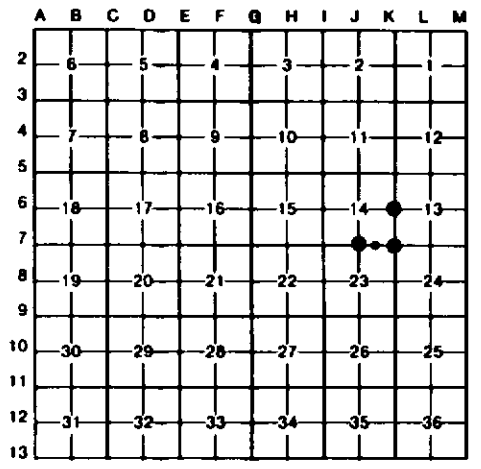

I, CARL F. ROSER, in a field survey on JUNE 16, 19 93, do hereby certify that under requirements of P.A. 74, Michigan P.A. of 1970, the corner points mentioned in lines 1 and 2 above were in conformance with regulations and rules therefore as required in the current manual of survey instructions of the United States Department of the Interior, Bureau of Land Management or by a decree of a Court of Law and/or that the corner points mentioned in lines 3, 4 and 5 above were in conformance with the rules of the Michigan Board of Land Surveyors or by a Decree of a Court of Law; established, re-established, monumented, re-monumented, recovered, found as expressed below:

NOTE: Not more than 4 corners, all in the same town and range, may be recorded on this certificate.

A. Description of original monument and accessories and/or subsequent restoration:

J-7 K-6 K-7 16

(NO EVIDENCE OF G.L.O. CORNER, B.T'S, LINE TREES & TOPOGRAPHY, AS CALLED OUT IN THE G.L.O. LINE NOTES; UNLESS NOTED IN ITEM "B" BELOW.)

B. Description of corner evidence found and/or method applied in restoring or reestablishing corner:

J-7
DROVE 1" PIPE IN DITCH ON N SIDE E-W SAND & GRAVEL RD FOR S 1/4 COR S-14. COR REESTABLISHED ON LINE ACROSS CALC N 1/4 COR & CTR OF S-14 AND ON LINE BETWEEN FD SE COR S-14 & REESTABLISHED SW COR S-14. COR FITS PROJECTION, REASONABLE, OF PS T. O'BRIEN'S CERT OF SUR IN S-11 & 14; Li. 001, Pg. 698.

K-6
ACCEPTED IRON ROD FOR E 1/4 COR S-14 AS SET BY P.S. T.O'BRIEN IN 1976 CERT SURVEY (Li.001-PG.698). COR SET SINGLE PROP BETWEEN K-5 AND K-7. N-S WINDING TRAIL IS 252'± E. ONE STRAND SMOOTH WIRE IS N-E-W. COR IS IN E-NE'LY COR OF TAG ALDER, SCATTERED HARDWOOD SWAMP.

K-7
FD 1/2" REROD ONE FOOT BELOW RD SURFACE FOR SE COR S-14. FD 3/8" X 9" ROD W/BATTERED P.S. CAP 1/2'± E OF REROD. DROVE 1" PIPE OVER 1/2" REROD & PUT 3/8" ROD INSIDE 1" PIPE. COR FALLS IN APPROX CTR E-W GRAVEL ROAD. CTR OF TRAIL RD NORTH IS 5'± EAST.

16
ESTABLISHED SW COR OF E 1/2 OF SE 1/4 OF SEC 14 PER STANDARD BLM INSTRUCTIONS. CTR OF E-W GRAVEL ROAD IS 10' SOUTH.

STATE OF MICHIGAN
CARL F. ROSER
LAND SURVEYOR
No. 12028
REGISTERED LAND SURVEYOR

C. Description of monument for corner and accessories established to perpetuate locating the position of the corner:

J-7
DROVE 1" X 96" GALV PIPE W/ALUM BNR CAP. SET CED POST.

6" B ASH	N50°E	31.5'
9" B ASH	N47°W	26.3'
CTR OF 29'± WIDE SAND & GRAVEL ROAD	SOUTH	23'

NO OTHER DECENT WIT'S AVAILABLE

K-6
DROVE 1" X 48" GALV PIPE W/ALUM BNR CAP OVER FD 3/8" IR ROD. SET CED POST.

7" MAPLE	N75°W	19.3'
18" TAMARACK	N35°E	48.4'
#11" CEDAR	N60°E	28.2'
#10" CEDAR	S50°E	20.5'

#RLS T.O'BRIEN 1976 WIT.

K-7
FD 1/2" REROD, & 3/8" IRON ROD W/RLS CAP. ADDED 1" X 15" GALV PIPE.

7" W PINE	N35°W	68.0'
10" W PINE	N40°E	96.9'
#10" MAPLE(CLP4)	S50°E	51.8'
10" TRPL MAPLE	S20°W	65.4'
SET CED POST W/ LOC TAG.	SOUTH	33'

#=RLS T.O'BRIEN WIT.

16
DROVE 5/8" X 34" REROD W/RLS CAP.

TW MAPLE	N60°W	41.0'
6" TAMARACK	N15°W	25.0'
6" TAMARACK	N65°E	46.0'
SET CED POST W/ LOC TAG.	NORTH	20'

Signed by Carl F. Roser Date 9-27-95

Surveyor's Michigan License No. 12028

FORM APPROVED BY MICHIGAN STATE BOARD OF LAND SURVEYORS, JAN. 28, 1971
REVISED MAY 14, 1975
REVISED JAN., 1983