LAND CORNER RECORDATION CERTIFICATE

Filing Requirement of Act 74, Mich. P.A. 1970

For corners in GLADWIN (County)

	Located In:	Corner Code ##
1. Public Land Survey	T 20N R 2E	H-7, I-6,
	T ___ R ___	I-7
	T ___ R ___	
	T ___ R ___	
2. Property Controlling	S 15 T ___ R ___	15
in Section	S ___ T ___ R ___	
3. Miscellaneous	S ___ T ___ R ___	
Property in Sec.	S ___ T ___ R ___	

Register of Deeds Stamp & File Number

4. Lot No. _____ , Recorded Plat _____
5. Private Claims _____

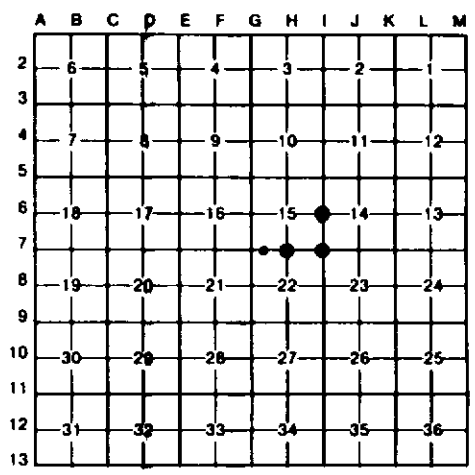

I, CARL F. ROSER, in a field survey on JUNE 9, 19 93, do hereby certify that under requirements of P.A. 74, Michigan P.A. of 1970, the corner points mentioned in lines 1 and 2 above were in conformance with regulations and rules therefore as required in the current manual of survey instructions of the United States Department of the Interior, Bureau of Land Management or by a decree of a Court of Law and/or that the corner points mentioned in lines 3, 4 and 5 above were in conformance with the rules of the Michigan Board of Land Surveyors or by a Decree of a Court of Law; established, re-established, monumented, re-monumented, recovered, found as expressed below:

NOTE: Not more than 4 corners, all in the same town and range, may be recorded on this certificate.

A. Description of original monument and accessories and/or subsequent restoration:

H-7 I-6 I-7 15

(NO EVIDENCE OF G.L.O. CORNER, B.T'S, LINE TREES & TOPOGRAPHY, AS CALLED OUT IN THE G.L.O. LINE NOTES; UNLESS NOTED IN ITEM "B" BELOW.)

B. Description of corner evidence found and/or method applied in restoring or reestablishing corner:

H-7	I-6	I-7	15
REESTABLISHED S 1/4 COR S-15 MIDWAY & ON LINE BETWEEN SW & SE SEC COR'S OF S-15. COR FALLS IN CTR E-W GRAVEL ROAD.	ACCEPTED FD T.O'BRIEN 2" OAK HUB FOR W 1/4 COR S-14. SEE L.C.R.C, Li. 1, Pg.142, DATED 3-12-76. COR DOES FIT U.S. STREAM TIES & SWP EDGE TO NORTH. CORNER IS NEAR NW CORNER OF SMALL ISLAND OF HIGH GROUND IN TAG ALDER-WILLOW SWAMP.	REESTABLISHED SE COR S-15 DOUBLE-OVER DISTANCE FROM FD SE COR S-14 AND REESTABLISHED S 1/4 COR S-14. CTR OF 29' WIDE E-W GRAVEL RD IS 2' SOUTH. SEE PS, TOM O'BRIENS CERT OF SUR IN SEC 11 & 14, Li. 1, Pg. 698; AND OUR L.C.R.C. FOR J-7 & K-7.	ESTABLISHED SE COR OF SW 1/4 OF SW 1/4 OF S-15 PER STANDARD BLM INSTRUCTIONS. CTR E-W GRAVEL ROAD IS 3' NORTH.

C. Description of monument for corner and accessories established to perpetuate locating the position of the corner:

H-7	I-6	I-7	15
DR 5/8" X 34" REROD W/RLS CAP.	FD SPK IN 2" HARDDWOOD HUB. REPL'D W/DNR MON, SET CED POST.	DR 5/8" X 34" REROD W/RLS CAP.	DR 5/8" X 34" REROD W/RLS CAP.
5" MAPLE(CLP3) N10°W 48.5'	6" W PINE N20°W 39.5'	12" W PINE N25°W 61.5'	10" B OAK N40°W 51.4'
4" OAK N20°E 44.1'	#12" MAPLE N35°E 51.1'	6" W PINE N35°E 67.1'	4" W PINE N45°E 67.0'
3" TWIN ASH S40°E 50.7'	#14" MAPLE S30°E 43.7'	14" W PINE S55°E 77.8'	16" R PINE S70°E 96.2'
5" ELM S20°W 47.2'	10" CEDAR S30°W 119.6'	7" R PINE S25°W 49.3'	3" W PINE S30°W 38.0'
SET CED POST W/ LOC TAG. NORTH 45'		SET CED POST W/ LOC TAG. NORTH 45'	SET CED POST W/ LOC TAG. NORTH 33'

#RLS T.O'BRIEN 1976 WIT.

Signed by Carl F. Roser Date 9-27-95

Surveyor's Michigan License No. 12028

STATE OF MICHIGAN CARL F. ROSER LAND SURVEYOR No. 12028 REGISTERED LAND SURVEYOR

FORM APPROVED BY THE MICHIGAN BOARD OF LAND SURVEYORS, JAN. 28, 1971
REVISED MAY 14, 1975
REVISED JAN., 1983