LAND CORNER RECORDATION CERTIFICATE

Filing Requirement of Act 74, Mich. P.A. 1970

For corners in GLADWIN (County)

	Located In:	Corner Code #
1. Public Land Survey	T 20N R 2E	6-6
	T ___ R ___	
	T ___ R ___	
	T ___ R ___	
2. Property Controlling	S 16 T ___ R ___	2, 5, 6
in Section	S ___ T ___ R ___	
3. Miscellaneous	S ___ T ___ R ___	
Property in Sec.	S ___ T ___ R ___	

Register of Deeds Stamp & File Number

4. Lot No. _____ , Recorded Plat _____
5. Private Claims _____

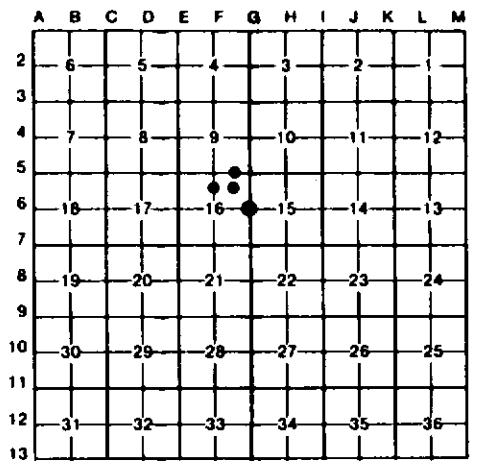

I, CARL F. ROSER, in a field survey on SEPTEMBER 16, 19 93, do hereby certify that under requirements of P.A. 74, Michigan P.A. of 1970, the corner points mentioned in lines 1 and 2 above were in conformance with regulations and rules therefore as required in the current manual of survey instructions of the United States Department of the Interior, Bureau of Land Management or by a decree of a Court of Law and/or that the corner points mentioned in lines 3, 4 and 5 above were in conformance with the rules of the Michigan Board of Land Surveyors or by a Decree of a Court of Law; established, re-established, monumented, re-monumented, recovered, found as expressed below:

NOTE: Not more than 4 corners, all in the same town and range, may be recorded on this certificate.

A. Description of original monument and accessories and/or subsequent restoration:

6-6 (NO EVIDENCE OF G.L.O. CORNER, B.T'S, LINE TREES & TOPOGRAPHY, AS CALLED OUT IN THE G.L.O. LINE NOTES; UNLESS NOTED IN ITEM "B" BELOW.)

B. Description of corner evidence found and/or method applied in restoring or reestablishing corner:

6-6	2	5	6
FD 3/4" REROD (REPLACED WITH 1"x 72" PIPE WITH ALUM DNR CAP) FOR E 1/4 COR S-16. COR FITS THREE G.HENNING WITS. (G.H. SAID "PLACED 5/8" X 36" BAR"). COR USED BY P.S. G.LEDY IN 1992 CERT OF SURVEY FOR N 1/2 OF S-16.	FD D. LEDY REROD FOR NW COR OF NE 1/4 OF NE 1/4 S-16. CORNER IS 4' NORTH OF CTR E-W GRAVEL DRIVE TO CABIN SW OF CORNER.	FD D. LEDY REROD FOR NE COR OF SE 1/4 OF NW 1/4 S-16. E-W WINDING TRAIL IS 22' SOUTH. ONE-STRAND OF SMOOTH WIRE, WINDING E-W, IS 52'± SOUTH.	FD D. LEDY REROD FOR THE CTR OF NE 1/4 S-16 ON 11-11-92. IRON HAS BEEN PULLED BUT FOUND HOLE WHERE IRON WAS (BY REMEAS FROM OUR TRAVERSE POINT) & DROVE 5/8" REROD IN HOLE AT POSITION OF LEDY IRON. COR FALLS ON TOP OF BANK, DROPS 10-12 FT. TO NORTH, TO GRASSY 100'+ WIDE CREEK BOTTOM.

C. Description of monument for corner and accessories established to perpetuate locating the position of the corner:

6-6			2			5			6		
FD 3/4" X 23" REROD. REPL'D W/DNR MON & SET CED POST.			FD 1/2" REROD W/RLS CAP.			FD 1/2" REROD W/RLS CAP. SET CED POST W/LOC TAG.			DR 5/8" X 34" REROD W/RLS CAP. SET CED POST W/LOC TAG.		
			5" MAPLE	N15°E	50.83'						
			22" R.PINE	N75°E	84.83'						
11" MAPLE	N38°W	35.68'	12" W.PINE	S60°E	118.98'	10" R.PINE	N50°E	30.1'	14" W.PINE	N15°W	4.71
WITH 16" MAPLE	S60°E	21.88'	12" TW MAPLE	S40°E	150.44'	7" W.PINE	S05°E	12.2'	8" W.PINE	N85°E	13.98'
14" MAPLE	S08°W	36.72'	NE COR WOOD BRIDGE			10" R.PINE	S40°W	2.1'	12" W.PINE	S75°E	16.89'
WITH 11" MAPLE	S50°W	33.09'	DECK	S80°W	73.9'	19" W.PINE	S80°W	10.5'	8" W.PINE	S30°W	10.87'
			SET CED POST W/ LOC TAG.	NORTH	10'						

WIT BY G.HENNING.
WIT BY RLS LEDY.

Signed by Carl F. Roser Date 9-27-95

Surveyor's Michigan License No. 12028

STATE OF MICHIGAN CARL F. ROSER LAND SURVEYOR 12028 REGISTERED LAND SURVEYOR

FORM APPROVED BY MICHIGAN STATE BOARD OF LAND SURVEYORS, JAN. 28, 1971
REVISED MAY 14, 1975
REVISED JAN., 1983