LAND CORNER RECORDATION CERTIFICATE

Filing Requirement of Act 74, Mich. P.A. 1970

For corners in GLADWIN (County)

	Located In:	Corner Code #
1. Public Land Survey	T 20N R 2E	E-6, E-7
	T ___ R ___	
	T ___ R ___	
	T ___ R ___	
2. Property Controlling in Section	S 16 T ___ R ___	4, 10
	S ___ T ___ R ___	
3. Miscellaneous Property in Sec.	S ___ T ___ R ___	
	S ___ T ___ R ___	

Register of Deeds Stamp & File Number

4. Lot No. _____, Recorded Plat _____
5. Private Claims _____

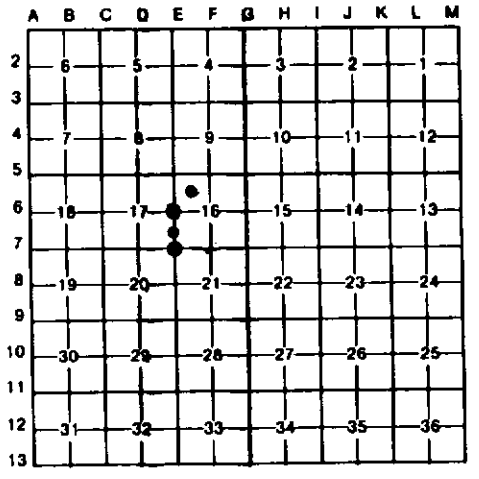

I, CARL F. ROSER, in a field survey on SEPTEMBER 16, 19 93, do hereby certify that under requirements of P.A. 74, Michigan P.A. of 1970, the corner points mentioned in lines 1 and 2 above were in conformance with regulations and rules therefore as required in the current manual of survey instructions of the United States Department of the Interior, Bureau of Land Management or by a decree of a Court of Law and/or that the corner points mentioned in lines 3, 4 and 5 above were in conformance with the rules of the Michigan Board of Land Surveyors or by a Decree of a Court of Law; established, re-established, monumented, re-monumented, recovered, found as expressed below:

NOTE: Not more than 4 corners, all in the same town and range, may be recorded on this certificate.

A. Description of original monument and accessories and/or subsequent restoration:

E-6 E-7 4 10

(NO EVIDENCE OF G.L.O. CORNER, B.T'S, LINE TREES & TOPOGRAPHY, AS CALLED OUT IN THE G.L.O. LINE NOTES; UNLESS NOTED IN ITEM "B" BELOW.)

STATE OF MICHIGAN
CARL F. ROSER
LAND SURVEYOR
No. 12028
REGISTERED LAND SURVEYOR

B. Description of corner evidence found and/or method applied in restoring or reestablishing corner:

E-6
FD 1/2" REROD FOR W 1/4 COR S-16. COR FITS G.HENNING SUR IN SW 1/4 S-16 AND ONE G.H. WIT. COR ALSO RECORDED BY J.MEYERS IN 1979 & D.LEDY IN 1992. COR IS IN LINE W/CTR OF GRVL RD NORTH & CTR TRAIL RD SOUTH. NAILED DEPT LOCATION TAG ON CEDAR POST (1 STRAND WIRE N & E) BESIDE FD 1 1/2" SOLID IRON, S85°E, 33'.

E-7
FD 5/8" REROD FOR SW COR S-16. (FITS ALL THREE G.HENNING WITS GOOD.) SOUTHERLY EDGE OF TITTABAWASSEE RV. IS 265' S, US= 4 CHS (264') FROM SOUTH EDGE OF RIVER. FOUND POSSIBLE W.PINE STUMP REMAINS N22°E, 21.1'; US = W.PINE 6 N28°E, 21.1'. FD CED POST ON GROUND AT CORNER WITH 1 STRAND SMOOTH WIRE N-S.

4
FD D.LEDY REROD FOR THE CTR OF NW 1/4 S-16. N-S WINDING TRAIL IS 66'± E.

10
FD 7/8" ROD FOR SW CORNER OF NW 1/4 OF SW 1/4 S-16 AS SET BY G.HENNING. ROD IS AT NW EDGE OLD CEDAR COR POST W/B.WIRE FENCE TO EAST AND SOUTH. ALL THREE OF G.HENNING WITS FIT GOOD.

C. Description of monument for corner and accessories established to perpetuate locating the position of the corner:

E-6
DR 1" X 24" GALV PIPE W/RLS CAP OVER FD 1/2" X 18" REROD.
12" TWIN MAPLE N70°E 43.86'
FD 1 1/2" DIA SOLID IRON S85°E 32.94'
5" TW W PINE S65°E 33.49'
‡11" W PINE S50°W 31.17'
8" MAPLE WEST 23.06'
‡=RLS D.LEDY WIT.
=RLS J.MEYERS WIT.

E-7
FD 5/8" REROD. ADDED RLS CAP. SET CEDAR POST.
‡16" R PINE N15°E 35.00'
‡ 8" MAPLE S20°E 36.75'
9" R PINE S35°W 8.17'
‡11" R PINE WEST 20.59'
‡RLS G.HENNING WIT.

4
FD 1/2" REROD W/LS CAP. SET CED POST W/LOC TAG.
3" W PINE N30°W 21.3'
21" W PINE S30°W 17.7'
10" MAPLE S75°W 11.2'

10
FD 7/8" THREADED BUCKER ROD. SET CED POST W/LOC TAG.
‡ 5" MAPLE N75°W 11.8'
7" MAPLE N55°W 14.4'
‡ 8" MAPLE N85°E 20.5'
14" TRPL MAPLE S30°E 43.2'
‡RLS G.HENNING WIT.

Signed by Carl F. Roser Date 9-27-95

Surveyor's Michigan License No. 12028

FORM APPROVED BY MICHIGAN STATE BOARD OF LAND SURVEYORS, JAN. 28, 1971
REVISED MAY 14, 1975
REVISED JAN., 1983