LAND CORNER RECORDATION CERTIFICATE

Filing Requirement of Act 74, Mich. P.A. 1970

For corners in GLADWIN (County)

	Located In:	Corner Code ##
1. Public Land Survey	T 20N R 2E	A-5
	T ___ R ___	A-6
	T ___ R ___	B-5
	T ___ R ___	
2. Property Controlling	S 18 T ___ R ___	1
in Section	S ___ T ___ R ___	
3. Miscellaneous	S ___ T ___ R ___	
Property in Sec.	S ___ T ___ R ___	

Register of Deeds Stamp & File Number

4. Lot No. _____ , Recorded Plat _____
5. Private Claims _____

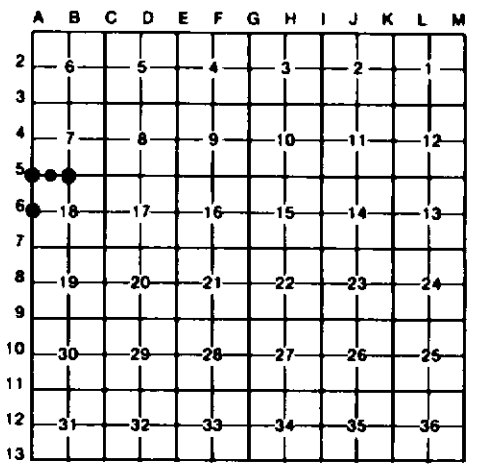

I, CARL T. KIISKILA , in a field survey on NOVEMBER 8 , 19 94 , do hereby certify that under requirements of P.A. 74, Michigan P.A. of 1970, the corner points mentioned in lines 1 and 2 above were in conformance with regulations and rules therefore as required in the current manual of survey instructions of the United States Department of the Interior, Bureau of Land Management or by a decree of a Court of Law and/or that the corner points mentioned in lines 3, 4 and 5 above were in conformance with the rules of the Michigan Board of Land Surveyors or by a Decree of a Court of Law; established, re-established, monumented, re-monumented, recovered, found as expressed below:

NOTE: Not more than 4 corners, all in the same town and range, may be recorded on this certificate.

A. Description of original monument and accessories and/or subsequent restoration:

A-5 A-6 B-5

(NO EVIDENCE OF G.L.O. CORNER, B.T'S, LINE TREES & TOPOGRAPHY, AS CALLED OUT IN THE G.L.O. LINE NOTES; UNLESS NOTED IN ITEM "B" BELOW.)

STATE OF MICHIGAN
CARL KIISKILA
LAND SURVEYOR
No. 33981
LICENSED LAND SURVEYOR

B. Description of corner evidence found and/or method applied in restoring or reestablishing corner:

A-5
FD & ACCEPTED 3/4" "T" IRON LOCATED AT THE INTERSECTION OF N-5 ROAD AND RD TO EAST. THIS IRON FITS A SURVEY DONE BY G. HENNING IN 1967.

A-6
FOUND AND ACCEPTED 1/2" REROD LOCATED ON THE CTR OF N-5 ROAD. THIS IRON FITS A SURVEY DONE BY G. HENNING IN 1967. CORNER IS 2' N OF NORTH EDGE OF GRAVEL ROAD LOOKING TO WEST.

B-5
FOUND AND ACCEPTED 1/2" IRON ROD 1' N OF CTR OF COUNTY ROAD. THIS IRON FITS A SURVEY DONE BY G. HENNING IN 1967.

1
FD AND ACCEPTED THE NW COR OF THE NE 1/4 OF THE FRL NW 1/4 SEC 18 AT THE PROPER PROPORTIONATE DISTANCE AND ON LINE BETWEEN FOUND SECTION CORNERS. REPLACED 1/2" REROD WITH 5/8" X 32" CAPPED REROD.

C. Description of monument for corner and accessories established to perpetuate locating the position of the corner:

A-5
FOUND "T" IRON IN RD INTERSECT.

#10" J PINE	S50°E	57.24'
#12" SPRUCE	S58°W	43.81'
#FENCE POST	N44°W	51.77'
4" W PINE	N43°E	57.80'

#OLD WITNESS BY OTHERS.

A-6
FD 1/2" REROD CTRLINE RD.

4" W PINE	N52°E	48.81'
18" W PINE	N88°E	56.34'
6" W PINE	S34°E	73.67'
5" TW W BIRCH	S66°W	49.98'
BOLD'S RD SIGN POST	N76°W	30.3'
YELLOW CED POST	S84°E	33.8'
CAPPED IR #29240,D.BURGIN	S84°E	32.95'

B-5
FD 1/2" IR ROD IN COUNTY RD.

6" ASH	N34°W	22.03'
6" ASH	N04°E	19.07'
10" ASH	S05°W	45.57'
6" MAPLE	S31°E	48.03'

1
FD 1/2"x 16" REROD (BENT). REPL'D WITH 5/8"x 32" REROD W/PS CAP.

7" W PINE	N51°W	89.07'
CTR DRIVEWAY SOUTH, WEST		81'
#13" R PINE	S63°W	77.28'
6" POPLAR	N48°E	35.93'
CTRLINE ROAD	NORTH	5'
CEDAR POST	SOUTH	33'

#= OLD WIT.

Signed by Carl T Kiiskila Date 1-23-96

Surveyor's Michigan License No. 33981

FORM APPROVED BY MICHIGAN STATE BOARD OF LAND SURVEYORS, JAN. 28, 1971
REVISED MAY 14, 1975
REVISED JAN., 1983